



8001 Forsyth Blvd.  
Floor 2  
St. Louis, MO 63105  
Microgrid-Solar.com  
314.292.5350

## SOLAR PV INSTALLATION PROJECT

### PROJECT CONTACTS

#### OWNER'S REPRESENTATIVE


Mark Weller  
MarkW@bsistl.com  
314.781.7820

#### PROJECT MANAGER

Marc Lopata, PE  
MLopata@MicrogridEnergy.com  
314.925.0563

#### PROJECT NUMBER

1303-01

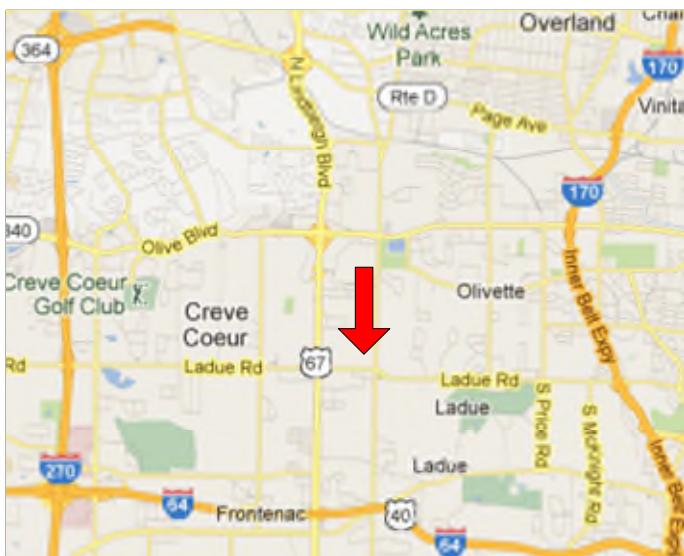

FOR

# MICDS

101 N Warson Road  
Ladue, MO 63124

RECORD DRAWINGS  
03/19/2014


98.43 kW GRID-INTERACTIVE SOLAR ARRAY  
(386) SOLARWORLD MODULES  
(386) ENPHASE ENERGY MICROINVERTERS  
IEEE-1547 AND UL-1741 COMPLIANT  
208V/3 $\phi$  INVERTER VOLTAGE  
208V/3 $\phi$  BUILDING SERVICE VOLTAGE  
FASTENED & BALLASTED MOUNTS  
22.6° & 10° TILT, 194° & 284° AZIMUTH  
AC DISCONNECT AT GROUND LEVEL  
ACCESIBLE FROM PUBLIC WAY

### SHEET INDEX

- PV-1 ARRAY LAYOUT
- PV-1A SUB-ARRAY 1 & 2 PLAN
- PV-1B SUB-ARRAY 3 & 4 PLAN
- PV-1C SUB-ARRAY 5 PLAN
- PV-1D SUB-ARRAY 1 & 2 RACKING PLAN
- PV-1E SUB-ARRAY 3 & 4 RACKING PLAN
- PV-1F SITE PLAN
- PV-2 PV RISER DIAGRAM
- PV-2A SINGLE-LINE DIAGRAM  
SUB-ARRAY 1&3
- PV-2B SINGLE-LINE DIAGRAM  
SUB-ARRAY 2&4
- PV-2C SINGLE-LINE DIAGRAM  
SUB-ARRAY 5 & POCC
- PS-1 PLACARD SPECIFICATIONS



PV Installation  
Professional  
Marc Lopata  
Cert # 091110-241

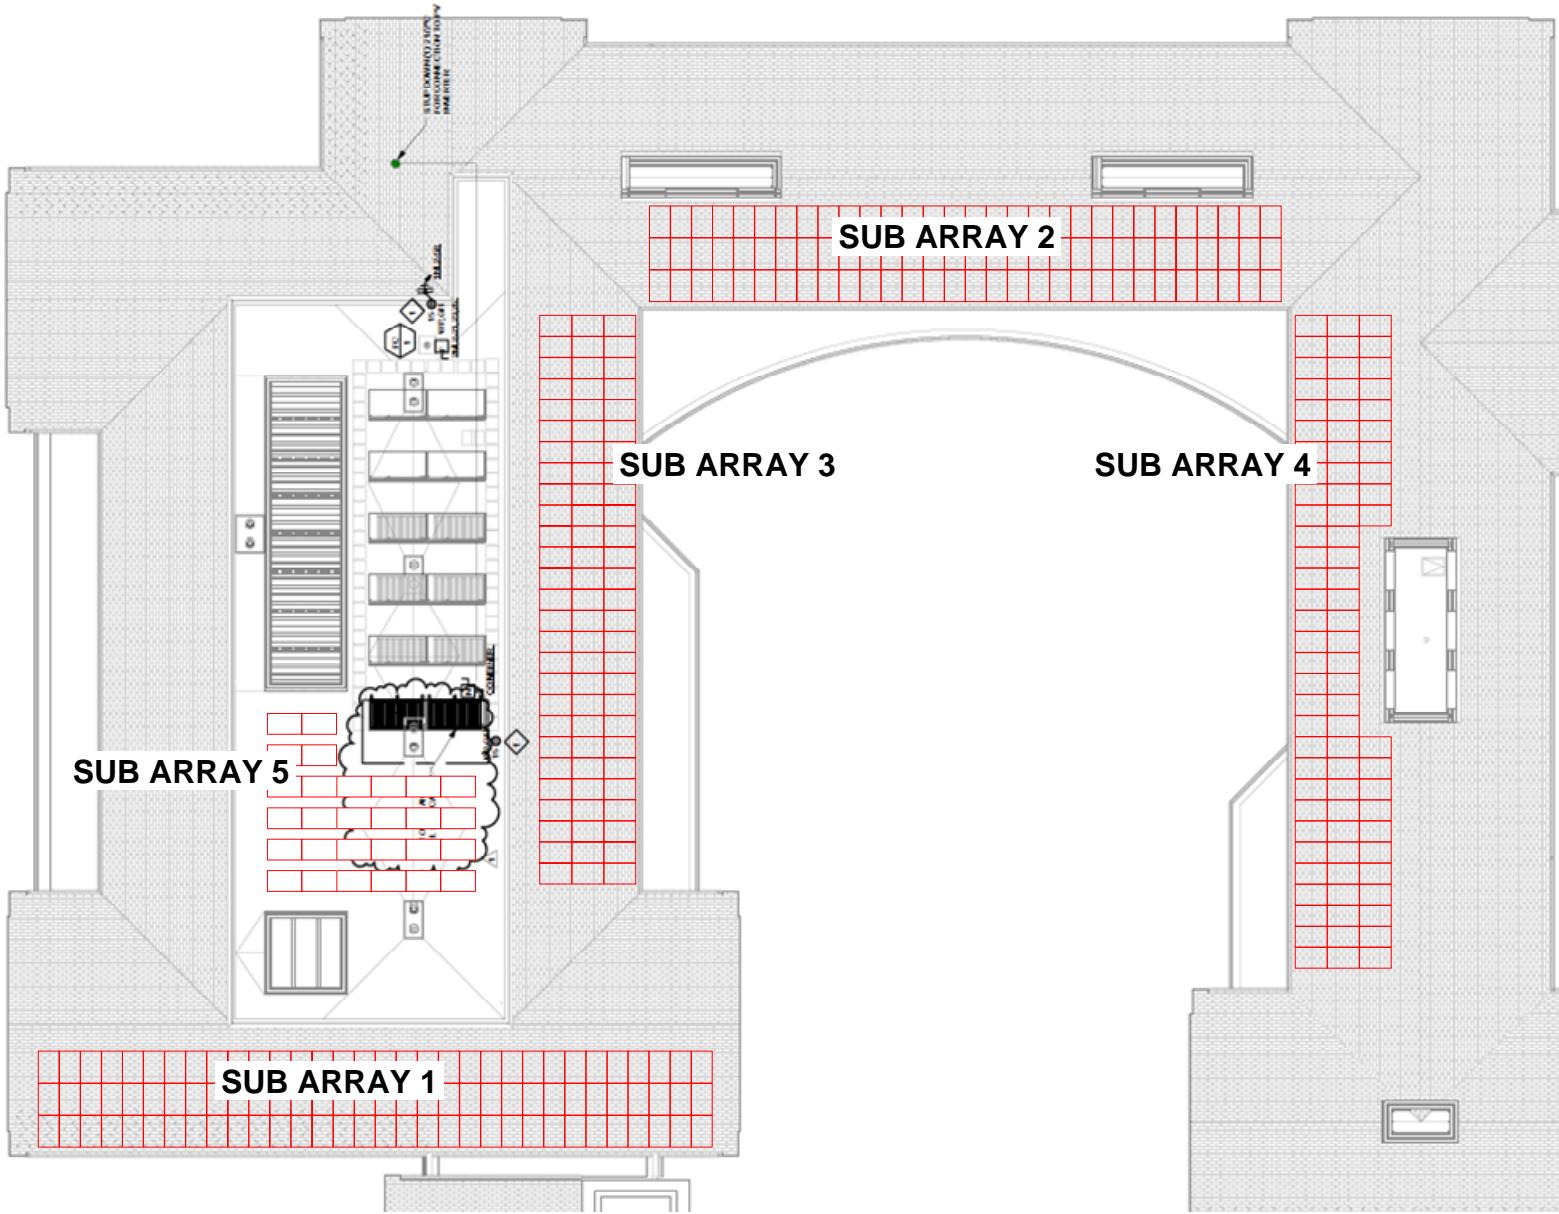

0      15      30  
SCALE IN FEET  
1" = 30'

PROJECT: MICDS  
SHEET TITLE: Array Layout  
SHEET NUMBER: PV-1  
VERSION: Record Drawings




5/20/13  
3/3/14

03/19/2014  
Scale: 1"=30'  
Drawn: TS  
Check: ML

8001 Forsyth Blvd.  
Floor 2  
St. Louis, MO 63105  
Microgrid-Solar.com  
314.292.5350

 Microgrid Solar



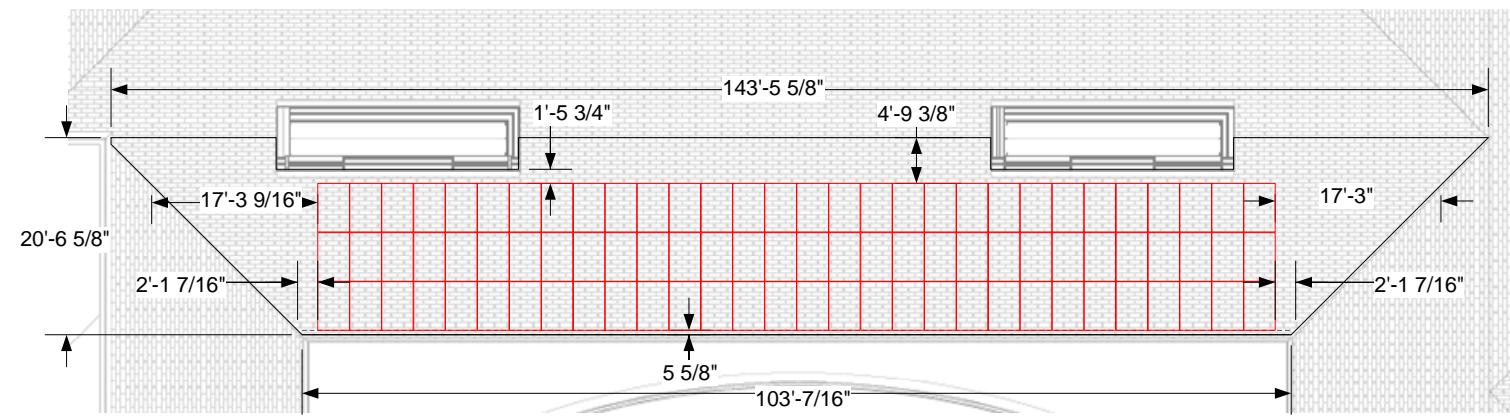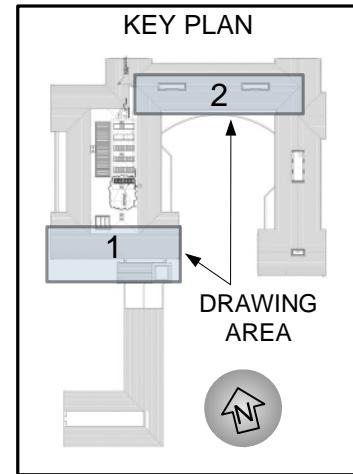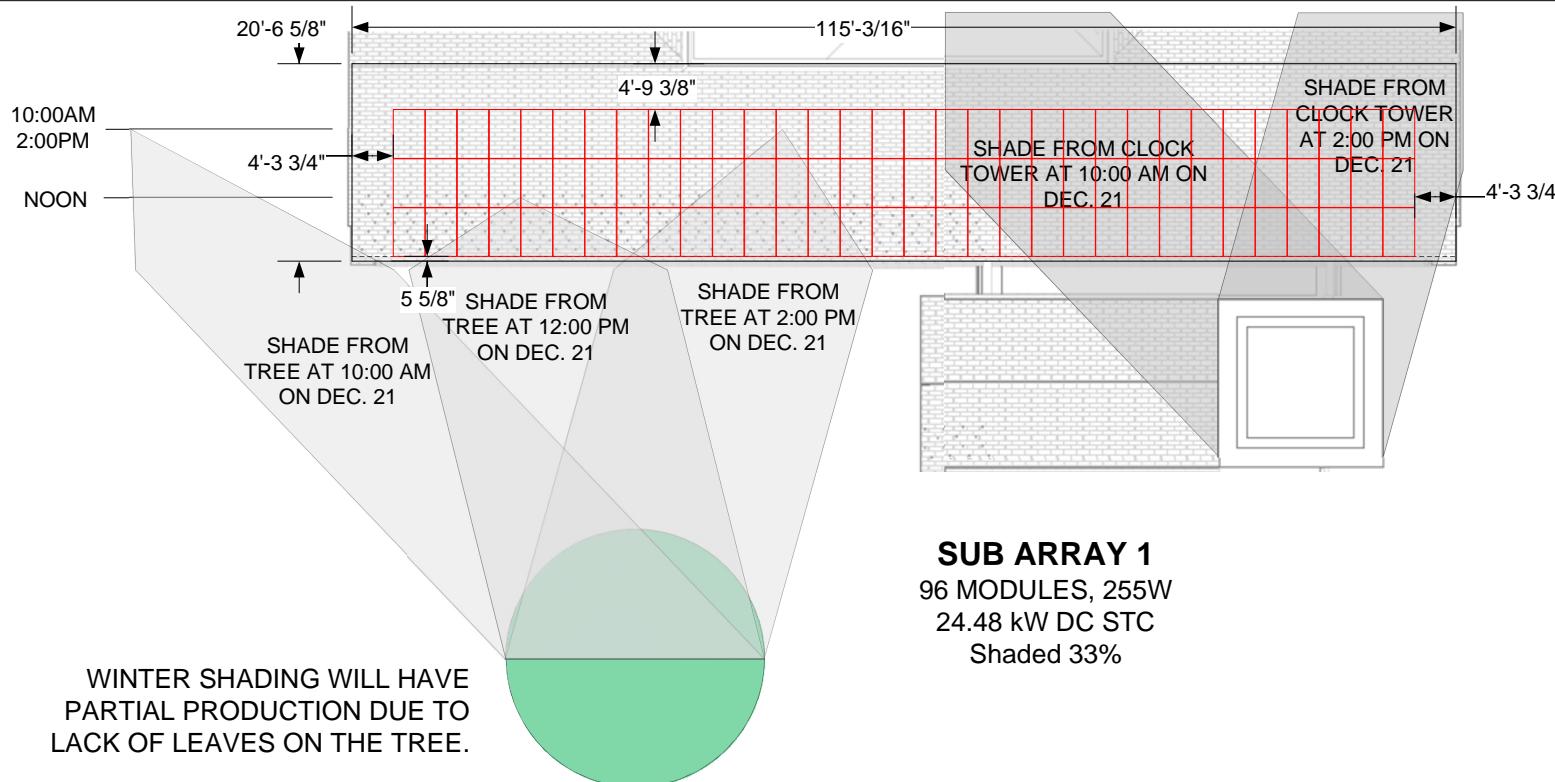


**SUB ARRAY 2**  
90 MODULES, 255W  
22.95 kW DC STC

6IN SETBACK



PROJECT: MICDS	SHEET TITLE: Sub-Array 1 & 2 Plan	2/28/13
SHEET NUMBER: PV-1A		3/05/13
VERSION: Record Drawings		3/08/13
03/19/2014	Scale: 1"=20'	5/20/13
	Drawn: TS	9/9/13
	Check: ML	
0	10	20
SCALE IN FEET		
1" = 20'		
8001 Forsyth Blvd.		
Floor 2		
St. Louis, MO 63105		
Microgrid-Solar.com		
314.292.5350		

Microgrid Solar



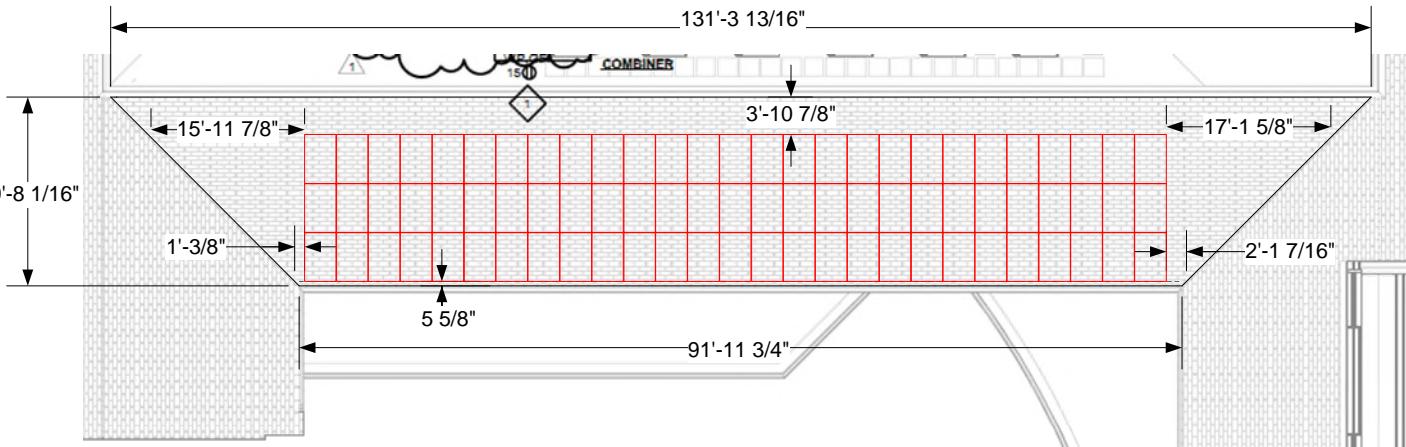

**SUB ARRAY 3**  
81 MODULES, 255W  
20.66 kW DC STC

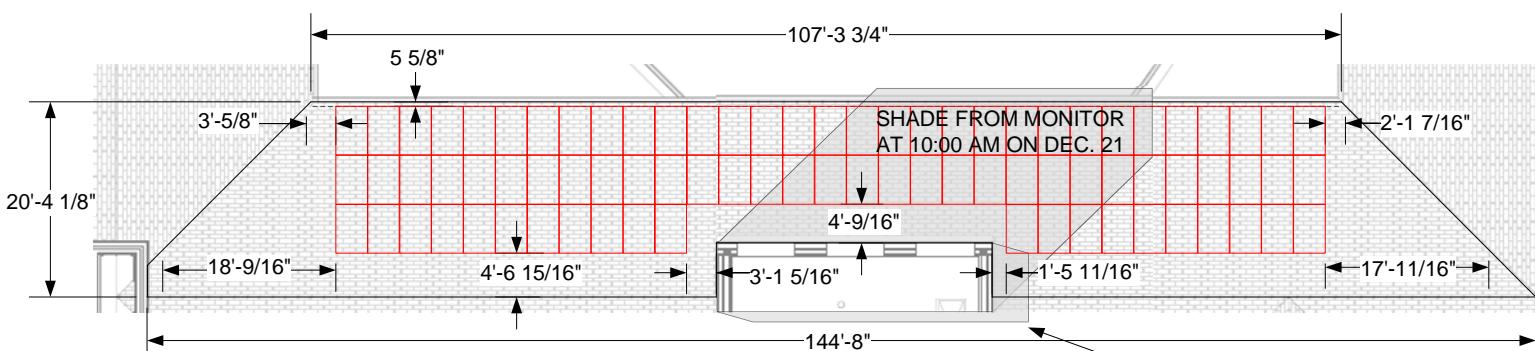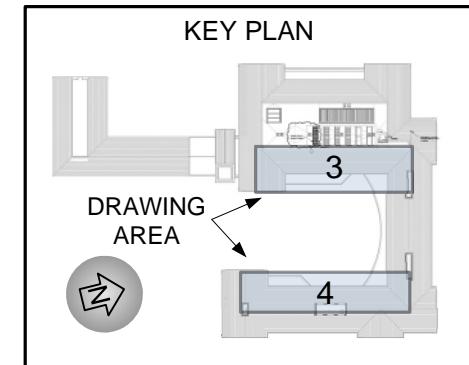

**SUB ARRAY 4**  
83 MODULES, 255W  
21.16 kW DC STC  
Shaded 10%

0 10 20  
SCALE IN FEET  
1" = 20'

PROJECT:	MICDS	2/28/13
SHEET TITLE:	Sub-Array 3 & 4 Plan	3/06/13
SHEET NUMBER:	PV-1B	3/08/13
VERSION:	Record Drawings	5/20/13
		9/9/13
03/19/2014	Scale: 1"=20'	
	Drawn: TS	Floor 2
	Check: ML	St. Louis, MO 63105
		Microgrid-Solar.com
		314.292.5350

6IN SETBACK

A

B



C

D

E

Microgrid Solar




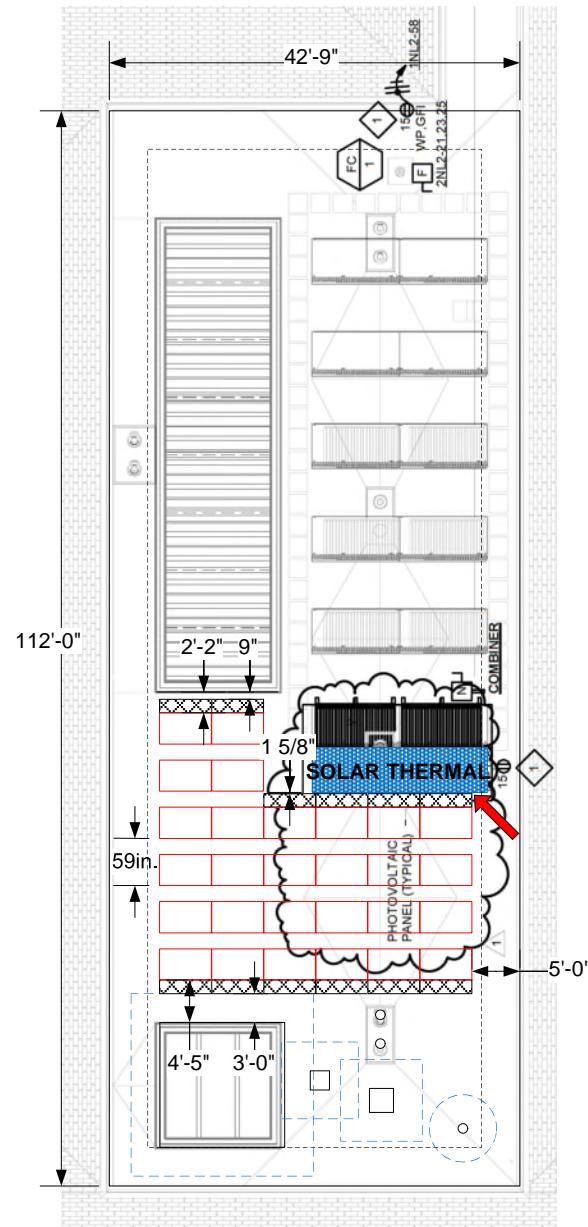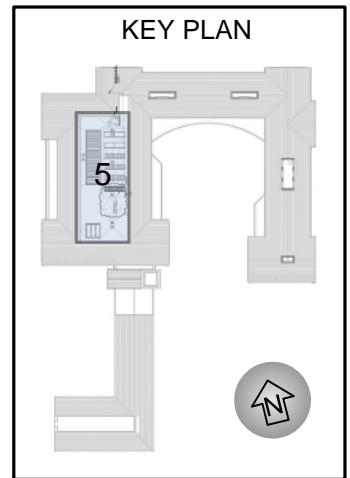

4 FOOT ROOF SETBACK


ARRAY ASSEMBLY REFERENCE POINT: SOLAR PV RACKING  
ASSEMBLY TO BE OFFSET FROM SOLAR THERMAL RACKING AS  
DETERMINED IN THE FIELD BY THE OWNER'S REPRESENTATIVE

**SUB ARRAY 5**  
28 MODULES, 255W  
7.14 kW

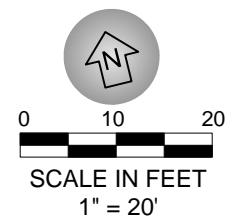

PROJECT:	MICDS	03/14/13
SHEET TITLE:	Sub-Array 5 Plan	5/20/13
SHEET NUMBER:	PV-1C	9/9/13
VERSION:	Record Drawings	9/26/13
		1/31/14
03/19/2014	8001 Forsyth Blvd.	
Scale: 1"=20'	Floor 2	
Drawn: TS	St. Louis, MO 63105	
Check: ML	Microgrid-Solar.com	
	314.292.5350	




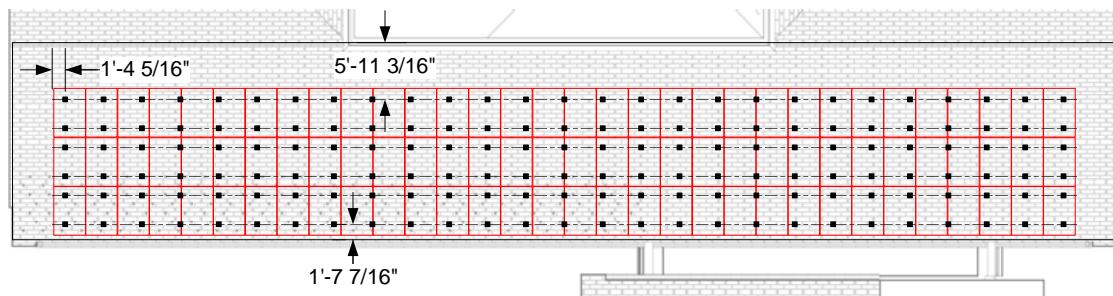

SUB-ARRAY 1 RACKING SCHEDULE

ROW	162" RAILS	122" RAILS	SPLICES	FEET
1	12	6	16	54
2	12	6	16	54
3	12	6	16	54

**SUB ARRAY 1**  
162 FASTEN POINTS

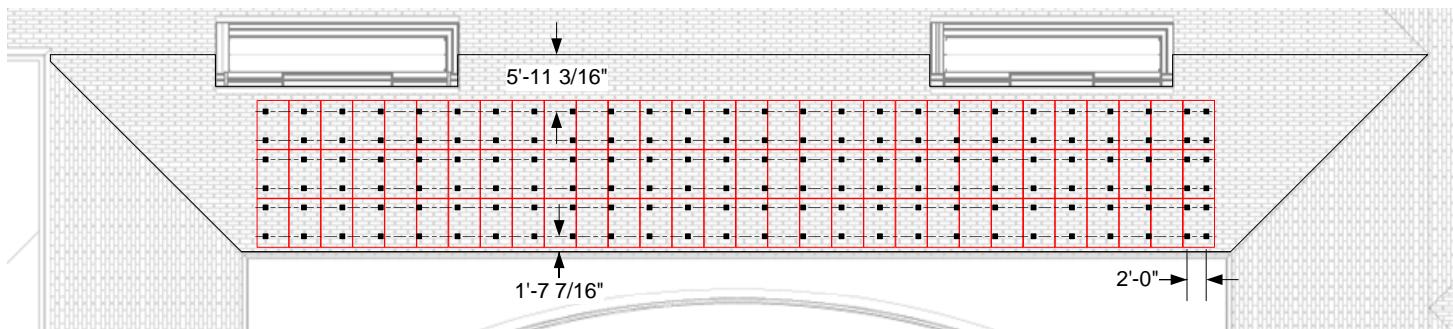



SUB-ARRAY 2 RACKING SCHEDULE

ROW	162" RAILS	122" RAILS	SPLICES	FEET
1	14	2	14	52
2	14	2	14	52
3	14	2	14	52

**SUB ARRAY 2**  
156 FASTEN POINTS

■ FOOT AND FLASHING ASSEMBLY  
(MAXIMUM 4 FT O.C.)

✓ MOUNTING RAIL  
(MAXIMUM 16 IN CANTILEVER)

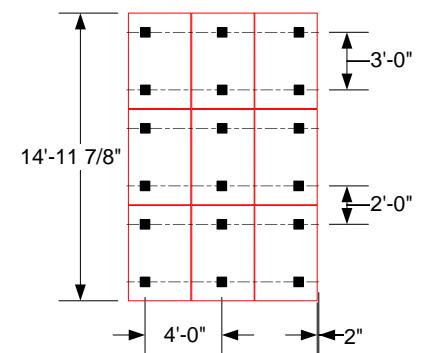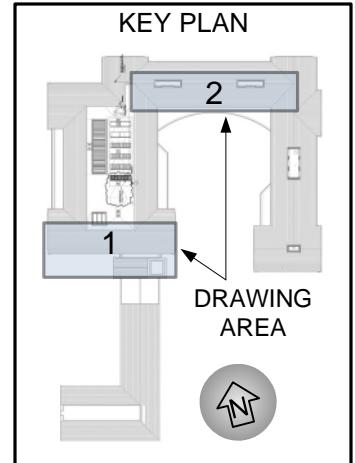

TYPICAL  
SCALE: 1"=10"

0 10 20

SCALE IN FEET

1" = 20'

PROJECT: MICDS  
SHEET TITLE: Sub Array 1 & 2 Racking Plan  
SHEET NUMBER: PV-1D  
VERSION: Record Drawings

3/07/13  
3/08/13  
5/20/13  
9/9/13

03/19/2014  
Scale: 1"=20'  
Drawn: TS  
Check: ML

8001 Forsyth Blvd.  
Floor 2  
St. Louis, MO 63105  
Microgrid-Solar.com  
314.292.5350

 Microgrid Solar





A

B

C

D

E

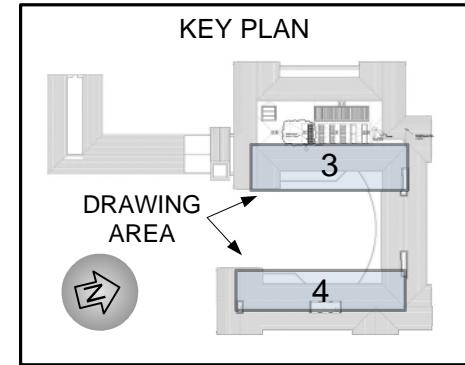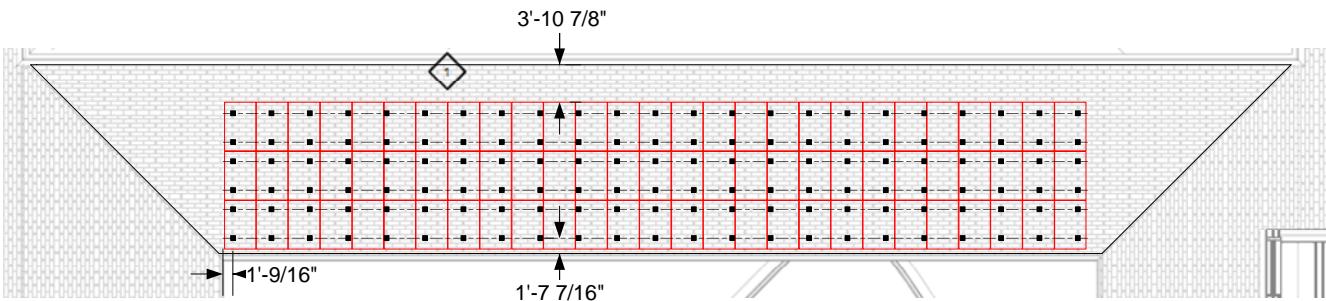


### SUB ARRAY 3

138 FASTEN POINTS

SUB-ARRAY 3 RACKING SCHEDULE

ROW	162" RAILS	122" RAILS	SPLICES	FEET
1	14	0	12	46
2	14	0	12	46
3	14	0	12	46

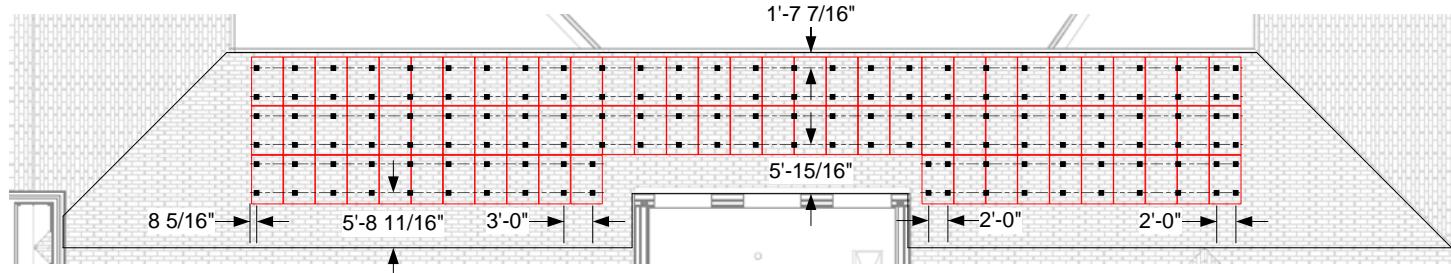

SUB-ARRAY 4 RACKING SCHEDULE


ROW	162" RAILS	122" RAILS	SPLICES	FEET
1	16	0	14	54
2	16	0	14	54
3A	6	0	4	20
3B	6	0	4	20

### SUB ARRAY 4


148 FASTEN POINTS

■ FOOT AND FLASHING ASSEMBLY  
(MAXIMUM 4 FT O.C.)

✓ MOUNTING RAIL  
(MAXIMUM 16 IN CANTILEVER)

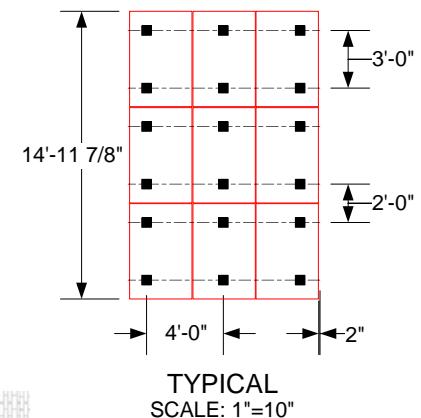

TYPICAL  
SCALE: 1"=10"

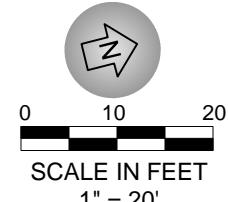

SCALE IN FEET  
1" = 20'

PROJECT:	MICDS	3/08/13
SHEET TITLE:	Sub Array 3 & 4 Racking Plan	5/20/13
SHEET NUMBER:	PV-1E	9/9/13
VERSION:	Record Drawings	
03/19/2014	Scale: 1"=20'	
	Drawn: TS	
	Check: ML	

AMERICAN  
SOLAR  
INSTITUTE  
CERTIFIED  
Solar PV  
Inverter

8001 Forsyth Blvd.  
Floor 2  
St. Louis, MO 63105  
Microgrid-Solar.com  
314.292.5350




A

B

C

D

E

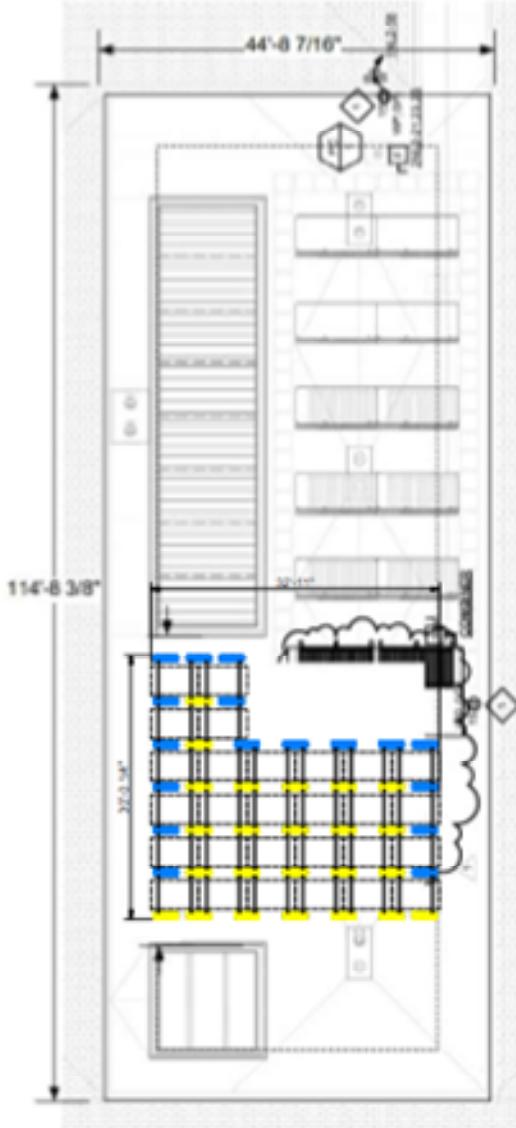

Applied Energy Technologies  
Engineered Solar Mounting Systems

www.AETenergy.com  
586-482-3774/5849  
586-482-3749/5848

**NOTES**  
1. THIS DRAWING CONTAINS INFORMATION WHICH IS THE PROPERTY OF APPLIED ENERGY TECHNOLOGIES, INC. AND IS NOT TO BE COPIED, REPRODUCED, OR DISCLOSED IN THE EXTERIOR OF THE SUBJECT PROPERTY, NUMBER OF ANY OTHER PERSON WITHOUT THE EXPRESS WRITTEN CONSENT OF APPLIED ENERGY TECHNOLOGIES, INC.  
2. THIS DRAWING IS AN APPROXIMATION AND IS INTENDED FOR CLUSTERING PURPOSES ONLY. APPLIED ENERGY TECHNOLOGIES, INC. IS NOT RESPONSIBLE FOR THE ACCURACY OF THIS DRAWING DUE TO THE INABILITY TO ACCURATELY DETERMINE THE EXACT LOCATION OF THE ROOFING SHEETS AND MEMBERS WHICH SUPPORT THE ROOFING SYSTEM.  
3. CONTRACTOR IS TO VERIFY ALL DIMENSIONS AND CONDITIONS IN THE FIELD AND REPORT ANY POSSIBLE DESIGN FLAWS TO APPLIED ENERGY TECHNOLOGIES, INC. IMMEDIATELY.  
4. STANDARD RIBBED CORRUGATED ROOFING SHEET. REFER TO ZINC SHEET FOR SHEET WEIGHT.  
5. MINIMUM FLOOR AND ROOF DECK ALLOWABLE TOLERANCE: 1/8"

**ITEM**

1

2

3


180

181

182

183

184</

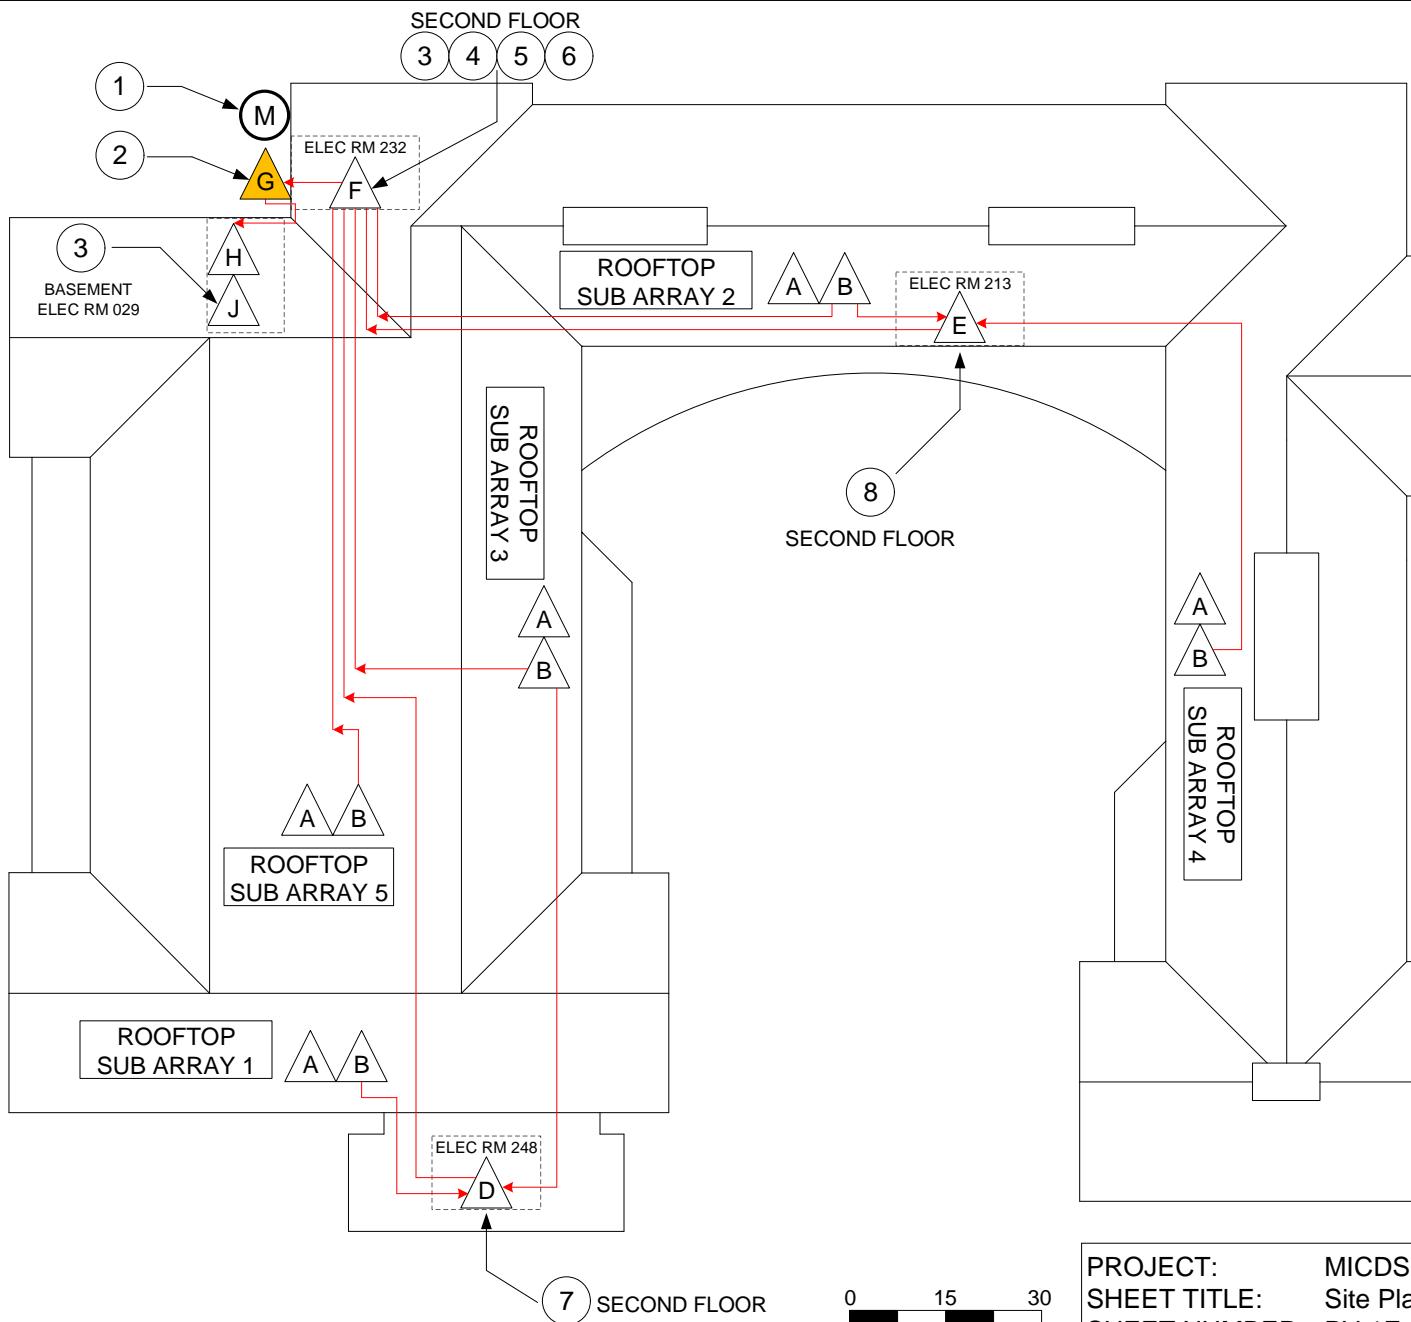

- SYSTEM COMPONENTS AS SHOWN ON SHEET PV-2A, PV-2B & PV-2C
- AC DISCONNECT
- PLACARD LOCATION AS LISTED ON PS-1
- PV CONNECTION POINT
- UTILITY METER

0 15 30  
SCALE IN FEET  
1" = 30'



PROJECT: MICDS  
SHEET TITLE: Site Plan  
SHEET NUMBER: PV-1F  
VERSION: Record Drawings  
03/19/2014  
Scale: N.T.S.  
Drawn: TS  
Check: ML

5/20/13  
3/3/14

8001 Forsyth Blvd.  
Floor 2  
St. Louis, MO 63105  
Microgrid-Solar.com  
314.292.5350

Microgrid Solar



NOTE: All components at ground level unless otherwise noted.


A

B

C

D

E

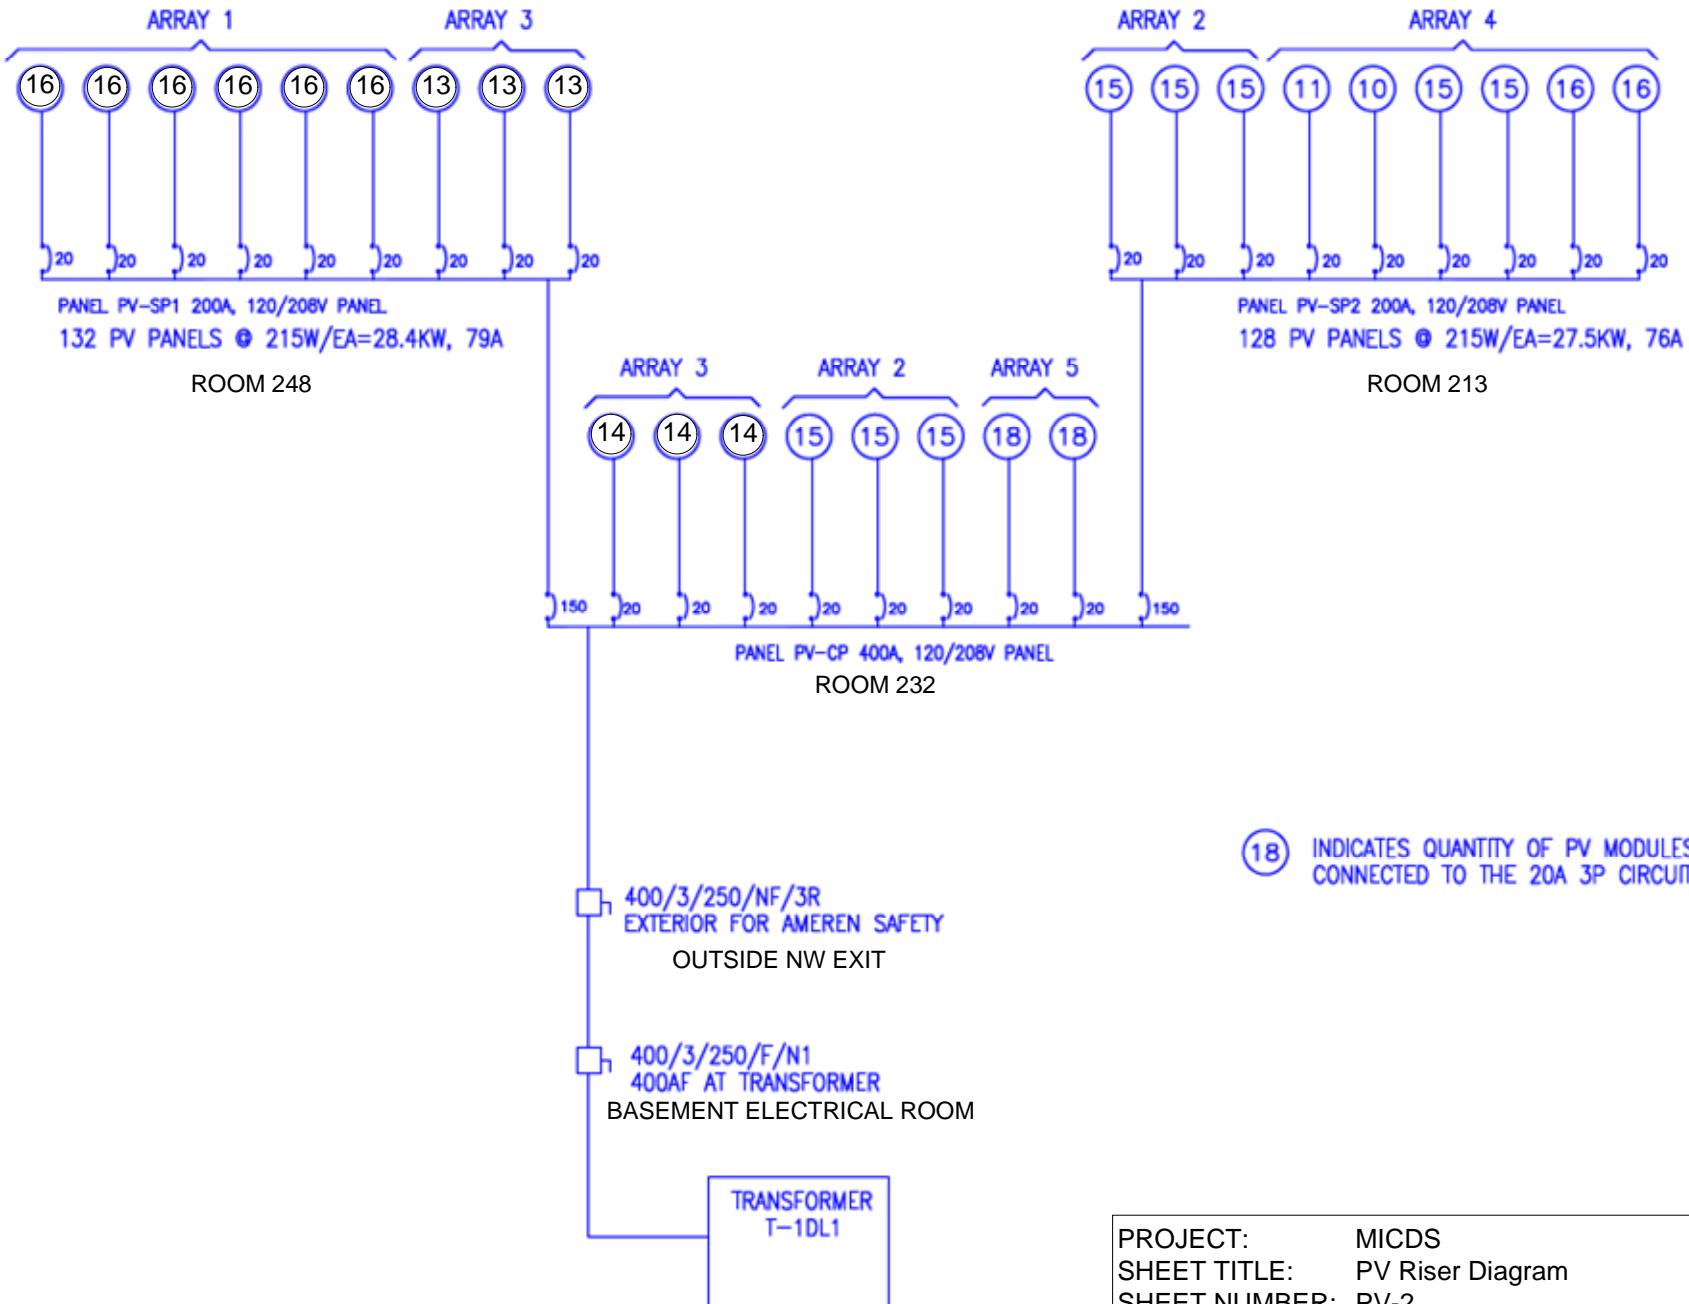

(18) INDICATES QUANTITY OF PV MODULES/MICRO INVERTERS CONNECTED TO THE 20A 3P CIRCUIT

PROJECT:	MICDS	5/20/13
SHEET TITLE:	PV Riser Diagram	
SHEET NUMBER:	PV-2	
VERSION:	Record Drawings	
03/19/2014	8001 Forsyth Blvd. Floor 2 St. Louis, MO 63105 Microgrid-Solar.com 314.292.5350	
Scale: N.T.S.		
Drawn: TS		
Check: ML		

Diagram by Briner Electric




### EQUIPMENT SCHEDULE


TAG	DESCRIPTION	QUANT	PART #	LOCATION	NOTES
A	PV MODULE(S)	177	ISFT-255	ROOF	255W, Isc=8.81A, Voc=37.9V
B	INVERTER(S)	177	M215	ROOF	0.58A/φ, 208V, 3φ, 4W
C	FLASHED JUNCTION BOX	4	"SD BOX"	ROOF	SOLADECk, 3R ENCLOSURE
D	AC COMBINER PANEL	1	"PV-SP1"	ELEC RM. 248	200A, 208V, 3φ, 4W

Components in heavy line type are EXISTING. All other components are NEW.

### SUB-ARRAY 1

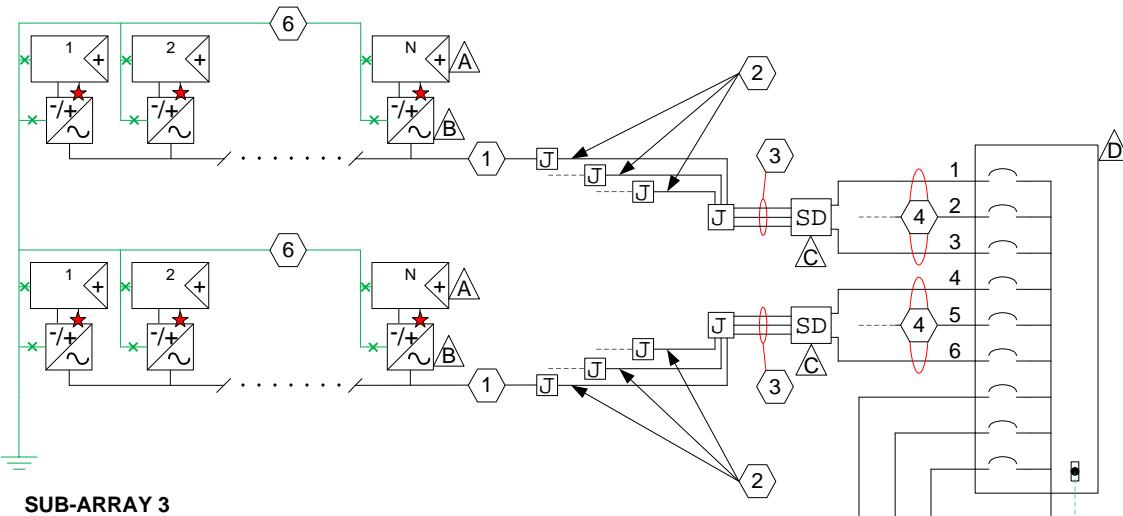

### SUB-ARRAY 3

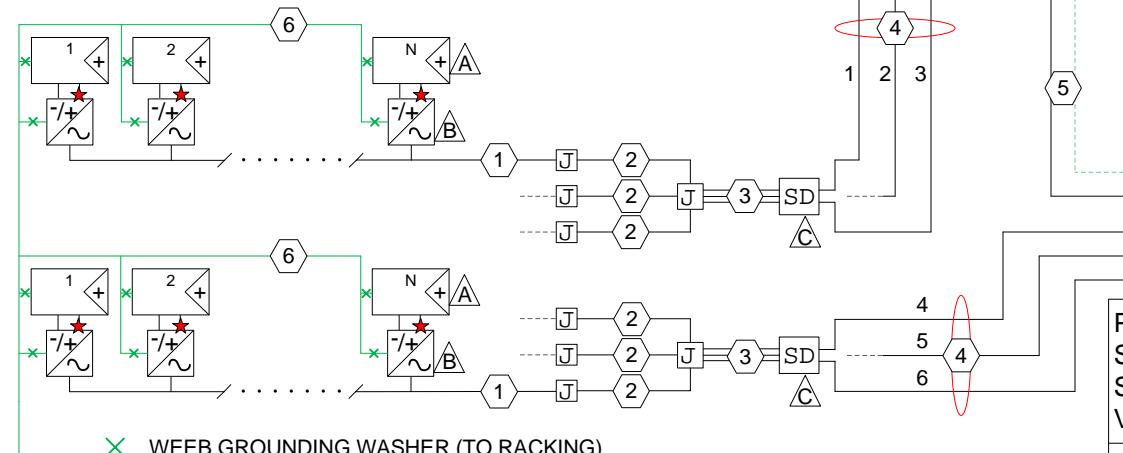

WEEB GROUNDING WASHER (TO RACKING)

EQUIPMENT GROUNDING CONDUCTOR (EGC)

GROUNDING ELECTRODE CONDUCTOR (GEC)

★ GROUNDING POINT OF THE CURRENT-CARRYING DC CONDUCTOR

### CONDUIT / CONDUCTOR SCHEDULE

TAG	DESC / CONDUCTOR TYPE	QUANT & GAUGE	CONDUIT
1	TRUNK CABLE, 3φ	3-#12C, 1-#12N, 1-#12G	NONE
2	THWN-2, AC EGC	3-#10C, 1-#12N, 1-#12G	3/4" EMT
3	THWN-2, AC EGC	9-#10C, 3-#12N, 1-#12G	(2) 3/4" EMT
4	THWN-2, AC EGC	SEE BRANCH SCHEDULE	1" & 3/4" EMT
5	THWN-2, AC EGC	3-3/0C, 1-#6N, 1-#6G	2" EMT
6	BARE CU DC GEC/EGC	1-#6G	NONE

BALANCED 3-PHASE AC SYSTEM, ONE PHASE SHOWN FOR CLARITY.

### SUB-ARRAY 1 BRANCH SCHEDULE

ID (#)	INVs (N)	VOLTS	AMP / φ	BREAKER	CONDUCTOR TAG ④
1-1	18	208	10.4	20/3	3-#10C, 1-#12N, 2-#12G
1-2	18	208	10.4	20/3	3-#10C, 1-#12N, 2-#12G
1-3	18	208	10.4	20/3	3-#10C, 1-#12N, 2-#12G
1-4	14	208	8.1	20/3	3-#10C, 1-#12N, 2-#12G
1-5	14	208	8.1	20/3	3-#10C, 1-#12N, 2-#12G
1-6	14	208	8.1	20/3	3-#10C, 1-#12N, 2-#12G

### SUB-ARRAY 3 BRANCH SCHEDULE

ID (#)	INVs (N)	VOLTS	AMP / φ	BREAKER	CONDUCTOR TAG ④
3-1	12	208	6.9	20/3	3-#10C, 1-#12N, 2-#12G
3-2	12	208	6.9	20/3	3-#10C, 1-#12N, 2-#12G
3-3	12	208	6.9	20/3	3-#10C, 1-#12N, 2-#12G
3-4	15	208	8.7	20/3	3-#10C, 1-#12N, 2-#12G
3-5	15	208	8.7	20/3	3-#10C, 1-#12N, 2-#12G
3-6	15	208	8.7	20/3	3-#10C, 1-#12N, 2-#12G

TO AC COMBINER PANEL PV-CP IN  
MAIN MECHANICAL ROOM ON  
GROUND LEVEL, SEE SHEET PV-2C

PROJECT:	MICDS	5/20/13
SHEET TITLE:	Single-Line Diagram – Sub-Array 1 & 3	5/28/13
SHEET NUMBER:	PV-2A	3/3/14
VERSION:	Record Drawings	
03/19/2014	Scale: N.T.S.	8001 Forsyth Blvd.
	Drawn: TS	Floor 2
	Check: ML	St. Louis, MO 63105
		Microgrid-Solar.com
		314.292.5350

 CERTIFIED Solar PV Installer

A

B

C

D


E

EQUIPMENT SCHEDULE


TAG	DESCRIPTION	QUANT	PART #	LOCATION	NOTES
A	PV MODULE(S)	173	ISFT-255	ROOF	255W, $I_{sc}=8.81A$ , $V_{oc}=37.9V$
B	INVERTER(S)	173	M215	ROOF	0.58A/ $\phi$ , 208V, 3 $\phi$ , 4W
C	FLASHED JUNCTION BOX	4	"SD BOX"	ROOF	SOLADECk, 3R ENCLOSURE
E	AC COMBINER PANEL	1	"PV-SP2"	ELEC RM. 213	200A, 208V, 3 $\phi$ , 4W

Components in heavy line type are EXISTING. All other components are NEW.

**SUB-ARRAY 4**

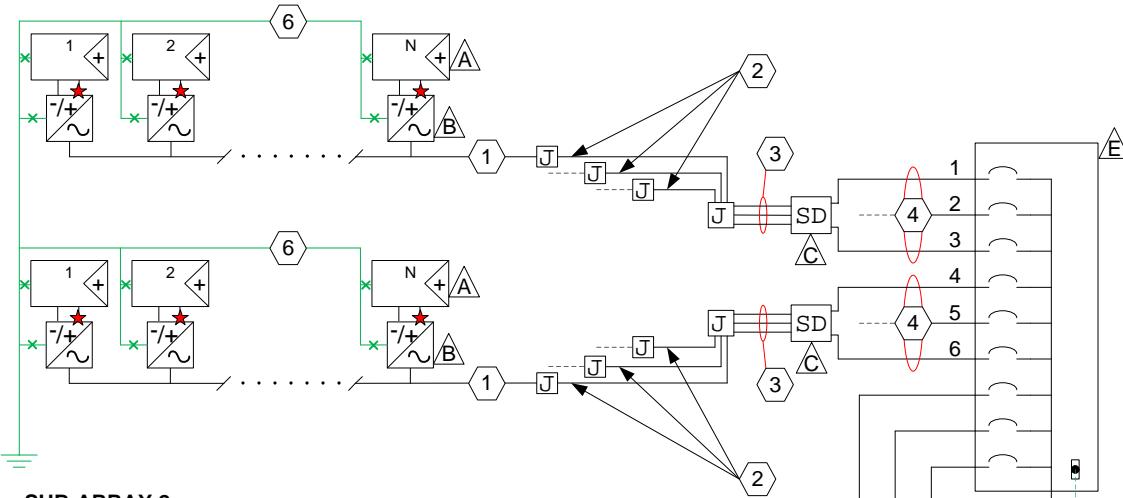

**SUB-ARRAY 2**

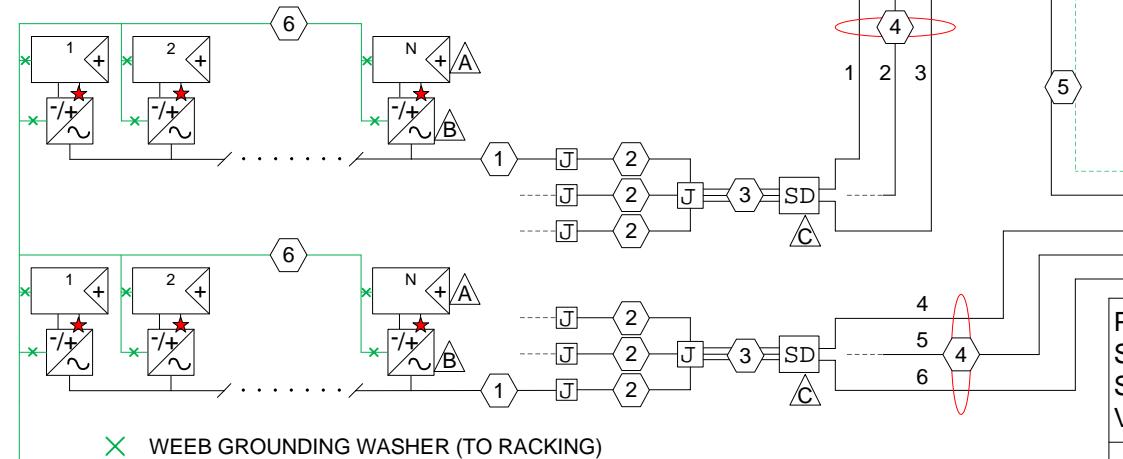

X WEEB GROUNDING WASHER (TO RACKING)

~ EQUIPMENT GROUNDING CONDUCTOR (EGC)

— GROUNDING ELECTRODE CONDUCTOR (GEC)

★ GROUNDING POINT OF THE CURRENT-CARRYING DC CONDUCTOR

CONDUIT / CONDUCTOR SCHEDULE

TAG	DESC / CONDUCTOR TYPE	QUANT & GAUGE	CONDUIT
1	TRUNK CABLE, 3 $\phi$	3-#12C, 1-#12N, 1-#12G	NONE
2	THWN-2, AC EGC	3-#10C, 1-#12N, 1-#12G	3/4" EMT
3	THWN-2, AC EGC	9-#10C, 3-#12N, 1-#12G	(2) 3/4" EMT
4	THWN-2, AC EGC	SEE BRANCH SCHEDULE	1" & 3/4" EMT
5	THWN-2, AC EGC	3-3/0C, 1-#6N, 1-#6G	2" EMT
6	BARE CU DC GEC/EGC	1-#6G	NONE

BALANCED 3-PHASE AC SYSTEM, ONE PHASE SHOWN FOR CLARITY.

**SUB-ARRAY 4 BRANCH SCHEDULE**

ID (#)	INVs (N)	VOLTS	AMP / $\phi$	BREAKER	CONDUCTOR TAG (4)
4-1	16	208	9.3	20/3	3-#8C, 1-#12N, 2-#12G
4-2	16	208	9.3	20/3	3-#8C, 1-#12N, 2-#12G
4-3	15	208	8.7	20/3	3-#8C, 1-#12N, 2-#12G
4-4	15	208	8.7	20/3	3-#10C, 1-#12N, 2-#12G
4-5	11	208	6.4	20/3	3-#10C, 1-#12N, 2-#12G
4-6	10	208	5.8	20/3	3-#10C, 1-#12N, 2-#12G

**SUB-ARRAY 2 BRANCH SCHEDULE**

ID (#)	INVs (N)	VOLTS	AMP / $\phi$	BREAKER	CONDUCTOR TAG (4)
2-1	15	208	8.7	20/3	3-#10C, 1-#12N, 2-#12G
2-2	15	208	8.7	20/3	3-#10C, 1-#12N, 2-#12G
2-3	15	208	8.7	20/3	3-#10C, 1-#12N, 2-#12G
2-4	15	208	8.7	20/3	3-#10C, 1-#12N, 2-#12G
2-5	15	208	8.7	20/3	3-#10C, 1-#12N, 2-#12G
2-6	15	208	8.7	20/3	3-#10C, 1-#12N, 2-#12G

TO AC COMBINER PANEL PV-CP IN  
MAIN MECHANICAL ROOM ON  
GROUND LEVEL, SEE SHEET PV-2C

PROJECT:	MICDS	5/20/13 3/3/14
SHEET TITLE:	Single-Line Diagram – Sub-Array 1 & 3	
SHEET NUMBER:	PV-2B	
VERSION:	Record Drawings	
03/19/2014	Scale: N.T.S.	8001 Forsyth Blvd.
	Drawn: TS	Floor 2
	Check: ML	St. Louis, MO 63105
		Microgrid-Solar.com
		314.292.5350

Microgrid Solar

CERTIFIED Solar PV Installer

A

B

C

D

E



## EQUIPMENT SCHEDULE

TAG	DESCRIPTION	QUANT	PART #	LOCATION	NOTES
A	PV MODULE(S)	36	SW 255	ROOF	255W, $I_{sc}=8.66A$ , $V_{oc}=37.8V$
B	INVERTER(S)	36	M215	ROOF	0.58A/ $\phi$ , 208V, 3 $\phi$ , 4W
F	AC COMBINER PANEL	1	"PV-CP"	ELEC RM. 232	400A, 208V, 3 $\phi$ , 4W
G	AC DISCONNECT	1	"PVD1"	N EXTERIOR WALL	208V, 3 $\phi$ , 4W
H	FUSED AC DISCONNECT	1	"PVFD2"	ELEC RM. 029	300A FUSE, 208V, 3 $\phi$ , 4W
J	CONNECTION POINT (POCC)	1	"T-1DL1"	ELEC RM. 029	300 kVA, 3 $\phi$ , 4W

Components in heavy line type are EXISTING. All other components are NEW.



## CONDUIT / CONDUCTOR SCHEDULE

TAG	DESC / CONDUCTOR TYPE	QUANT & GAUGE	CONDUIT
1	TRUNK CABLE, 3 $\phi$	3-#12C, 1-#12N, 1-#12G	NONE
2	THWN-2, AC EGC	SEE BRANCH SCHEDULE	3/4" EMT
3	THWN-2, AC EGC	3-3/0C, 1-#6N, 1-#6G	2" EMT
4	THWN-2, AC EGC	SEE BRANCH SCHEDULE	1" EMT
5	THWN-2, AC EGC	SEE BRANCH SCHEDULE	1" EMT
6	THWN-2, AC EGC	3-3/0C, 1-#6N, 1-#6G	2" EMT
7	THWN-2, AC EGC	3-500MCM, 1-500MCMN, 1-1/0G	2 1/2" EMT
8	BARE CU DC GEC/EGC	1-#6G	NONE

BALANCED 3-PHASE AC SYSTEM, ONE PHASE SHOWN FOR CLARITY.

## SUB-ARRAY 5 BRANCH SCHEDULE

ID (#)	INVs (N)	VOLTS	AMP / $\phi$	BREAKER	CONDUCTOR TAG (2)
1	18	208	10.4	20/3	3-#10C, 1-#12N, 2-#12G
2	18	208	10.4	20/3	3-#10C, 1-#12N, 2-#12G


## SUB-ARRAY 2 BRANCH SCHEDULE

ID (#)	INVs (N)	VOLTS	AMP / $\phi$	BREAKER	CONDUCTOR TAG (4)
4	15	208	8.7	20/3	3-#10C, 1-#12N, 2-#12G
5	15	208	8.7	20/3	3-#10C, 1-#12N, 2-#12G
6	15	208	8.7	20/3	3-#10C, 1-#12N, 2-#12G

## SUB-ARRAY 3 BRANCH SCHEDULE

ID (#)	INVs (N)	VOLTS	AMP / $\phi$	BREAKER	CONDUCTOR TAG (5)
4	15	208	8.7	15/3	3-#10C, 1-#12N, 2-#12G
5	15	208	8.7	15/3	3-#10C, 1-#12N, 2-#12G
6	15	208	8.7	15/3	3-#10C, 1-#12N, 2-#12G

## SUB-ARRAY 5

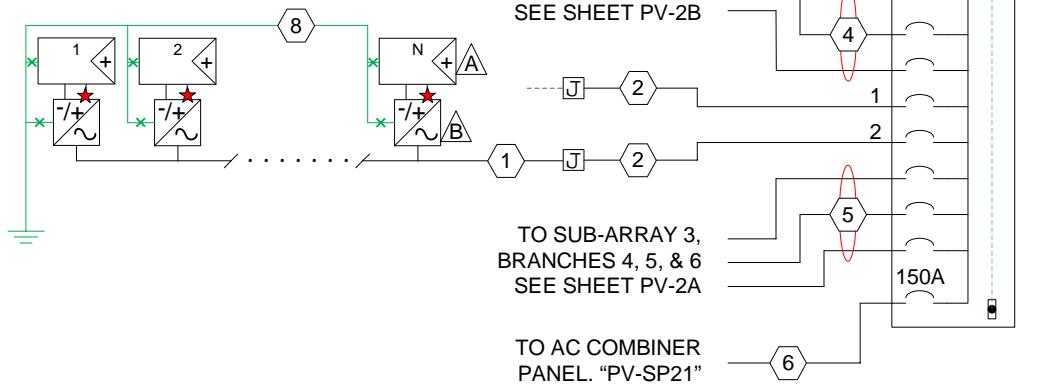

✖ WEEB GROUNDING WASHER (TO RACKING)

~~~~ EQUIPMENT GROUNDING CONDUCTOR (EGC)

~~~~ GROUNDING ELECTRODE CONDUCTOR (GEC)

★ GROUNDING POINT OF THE CURRENT-CARRYING DC CONDUCTOR

PROJECT: MICDS  
 SHEET TITLE: Single-Line Diagram – Sub-Array 5 & POCC  
 SHEET NUMBER: PV-2C  
 VERSION: Record Drawings

5/20/13  
 3/3/14

03/19/2014  
 Scale: N.T.S.  
 Drawn: TS  
 Check: ML

 Microgrid Solar

8001 Forsyth Blvd.  
 Floor 2  
 St. Louis, MO 63105  
 Microgrid-Solar.com  
 314.292.5350



A

B

C

D

E

## PV MODULE RATINGS @ STC

|                              |              |
|------------------------------|--------------|
| MODULE MAKE                  | SOLARWORLD   |
| MODULE MODEL                 | SW 255W MONO |
| MAX POWER-POINT CURRENT, Imp | 8.15 A       |
| MAX POWER-POINT VOLTAGE, Vmp | 31.4 V       |
| OPEN-CIRCUIT VOLTAGE, Voc    | 37.8 V       |
| SHORT-CIRCUIT CURRENT, Isc   | 8.66 A       |
| MAX SERIES FUSE (OCPD)       | 16 A         |
| MAXIMUM POWER, Pmax          | 255 W        |
| MAX VOLTAGE (TYP 600V)       | 600 V        |
| VOC TEMP COEFF [%/°C]        | -0.33        |

## INVERTER RATINGS

|                       |         |
|-----------------------|---------|
| INVERTER MAKE         | ENPHASE |
| INVERTER MODEL        | M215    |
| MAX DC VOLTAGE RATING | 45 V    |
| MAX POWER @ 40°C      | 215 W   |
| NOMINAL AC VOLTAGE    | 208 V   |
| MAX AC CURRENT        | 1.0 A   |
| MAX OCPD RATING       | N/A     |

### 1 AC METER - PRIMARY

**CAUTION**

ONSITE ENERGY GENERATION  
**SOLAR PHOTOVOLTAIC ARRAY**  
 IEEE-1547 COMPLIANT – WILL  
 NOT PRODUCE VOLTAGE  
 WHEN GRID POWER IS OFF

### 3 AC CONNECTION POINT

**PHOTOVOLTAIC  
 INVERTER CONNECTION**

|  |       |
|--|-------|
| AC OUTPUT CURRENT  | 300 A |
| NOMINAL AC VOLTAGE                                       | 208 V |
| THIS DEVICE IS FED BY MULTIPLE SOURCES (UTILITY & SOLAR) |       |

### 4 AC CONNECTION POINT

**WARNING**

ELECTRIC SHOCK HAZARD  
 IF A GROUND FAULT IS INDICATED  
 AT ANY INVERTER, NORMALLY  
 GROUNDED CONDUCTORS MAY BE  
 UNGROUNDED AND ENERGIZED

### 2 AC DISCONNECT

**SOLAR PV SYSTEM  
 AC DISCONNECT**

|  |       |
|--|-------|
| AC OUTPUT CURRENT  | 300 A |
| NOMINAL AC VOLTAGE                                       | 208 V |
| THIS DEVICE IS FED BY MULTIPLE SOURCES (UTILITY & SOLAR) |       |

### 5 PANEL PV-CP

BREAKERS FOR SUB-ARRAY 3  
 BRANCHES 1, 2 & 3 ON  
 PANEL PV-SP1 LOCATED IN  
 ELECTRICAL ROOM 248.

**KEY LOCATION NOTES**  
 LOCATED AS SHOWN ON  
 SHEET SERIES PV-1G

### 6 PANEL PV-CP

BREAKERS FOR SUB-ARRAY 2  
 BRANCHES 1, 2 & 3 ON  
 PANEL PV-SP2 LOCATED IN  
 ELECTRICAL ROOM 213

### 7 PANEL PV-SP1

BREAKERS FOR SUB-ARRAY 3  
 BRANCHES 4, 5 & 6 ON  
 PANEL PV-SP2 LOCATED IN  
 ELECTRICAL ROOM 213

### 8 PANEL PV-SP2

BREAKERS FOR SUB-ARRAY 2  
 BRANCHES 4, 5 & 6 ON  
 PANEL PV-SP2 LOCATED IN  
 ELECTRICAL ROOM 248

PROJECT: MICDS  
 SHEET TITLE: Placard Specification  
 SHEET NUMBER: PS-1  
 VERSION: Record Drawings

05/20/13  
 03/03/14

03/19/2014  
 Scale: N.T.S.  
 Drawn: TS  
 Check: ML



8001 Forsyth Blvd.  
 Floor 2  
 St. Louis, MO 63105  
 Microgrid-Solar.com  
 314.292.5350




A

B

C

D

E

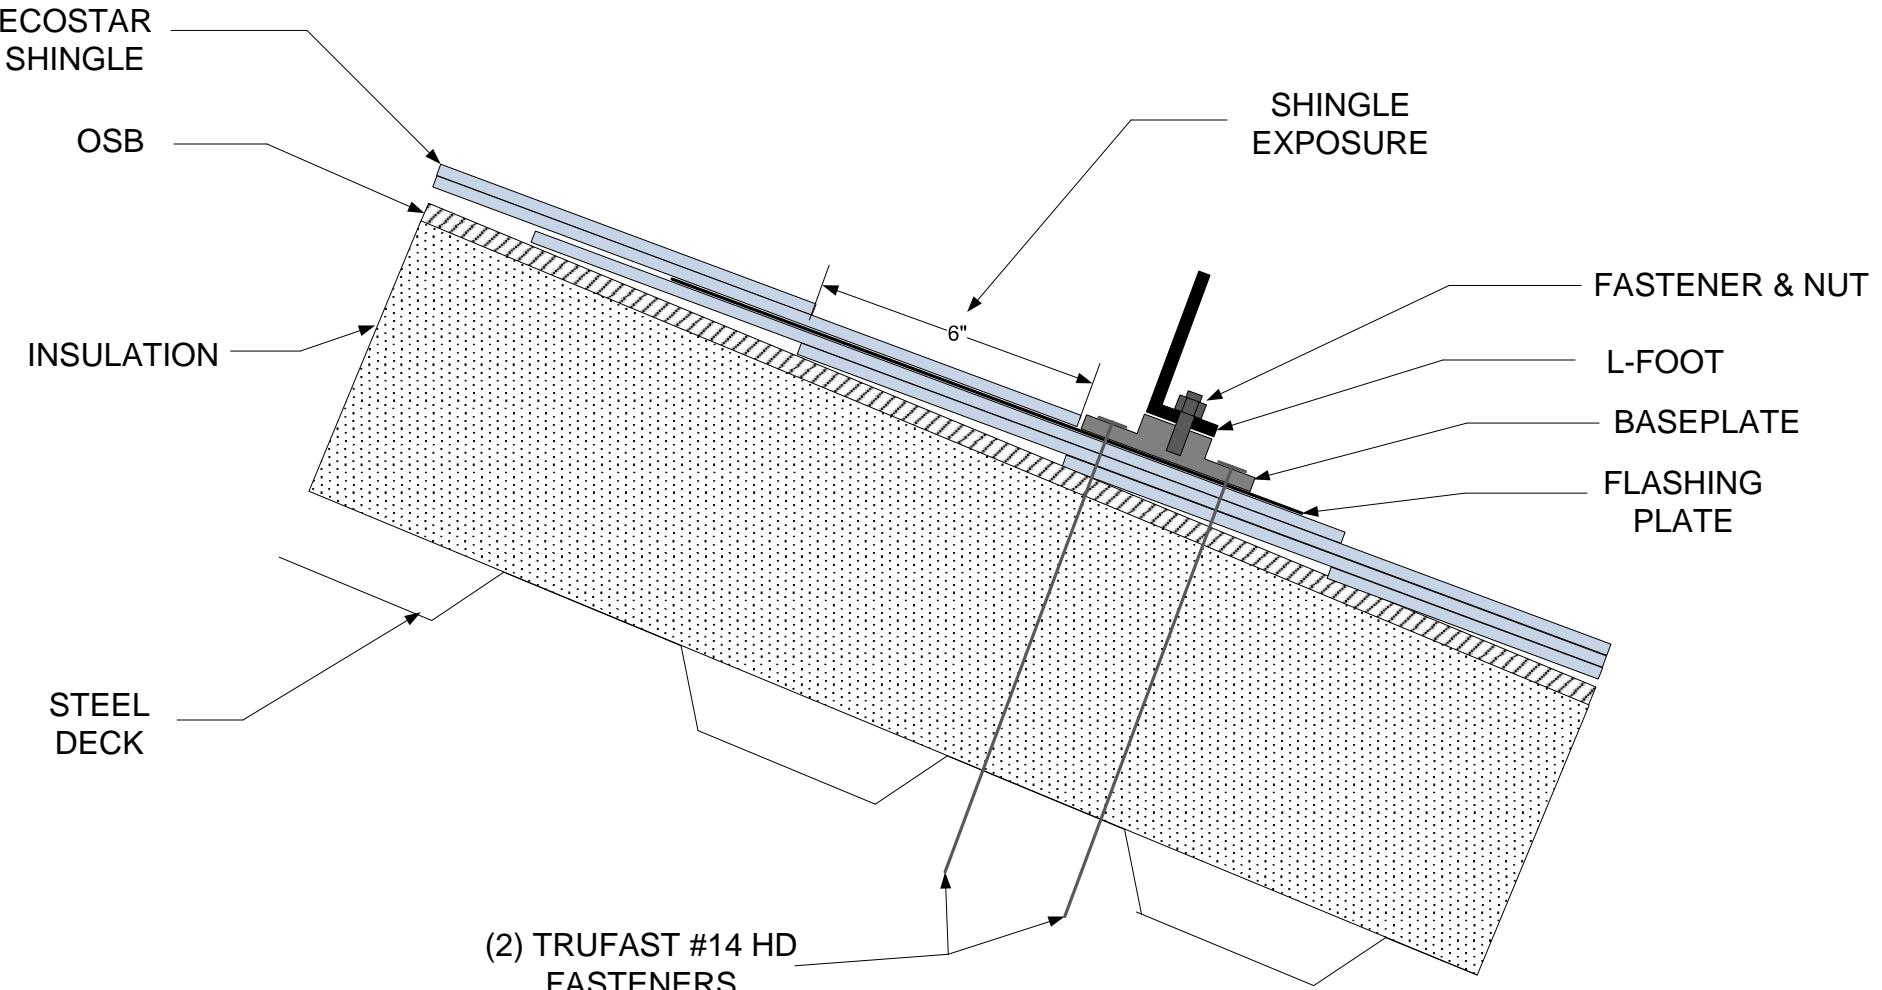

0 3 6  
SCALE IN INCHES

3" = 1'

NOTES:

- (1) SHINGLE EXPOSURE OF 6" REQUIRED.
- (2) 18 GAUGE STEEL DECK – 1.5" FROM BOTTOM FLUTE TO TOP FLUTE.
- (2) INSULATION & OSB THICKNESS: 6.44"
- (3) ECOSTAR SHINGLE THICKNESS:  $\frac{1}{4}$ "

|   |                                     |   |
|---|-------------------------------------|---|
| PROJECT: MICDS  | SHEET TITLE: Flashing Cross Section | 04/09/13  |
| SHEET NUMBER: PS-1  | VERSION: Record Drawings            |   |
| 09/26/2013  | Scale: 3"=1'<br>Drawn: PK<br>Check: | 8001 Forsyth Blvd.<br>Floor 2<br>St. Louis, MO 63105<br>Microgrid-Solar.com<br>314.292.5350 |
|  Microgrid Solar |                                     |        |


A

B

C

D

E

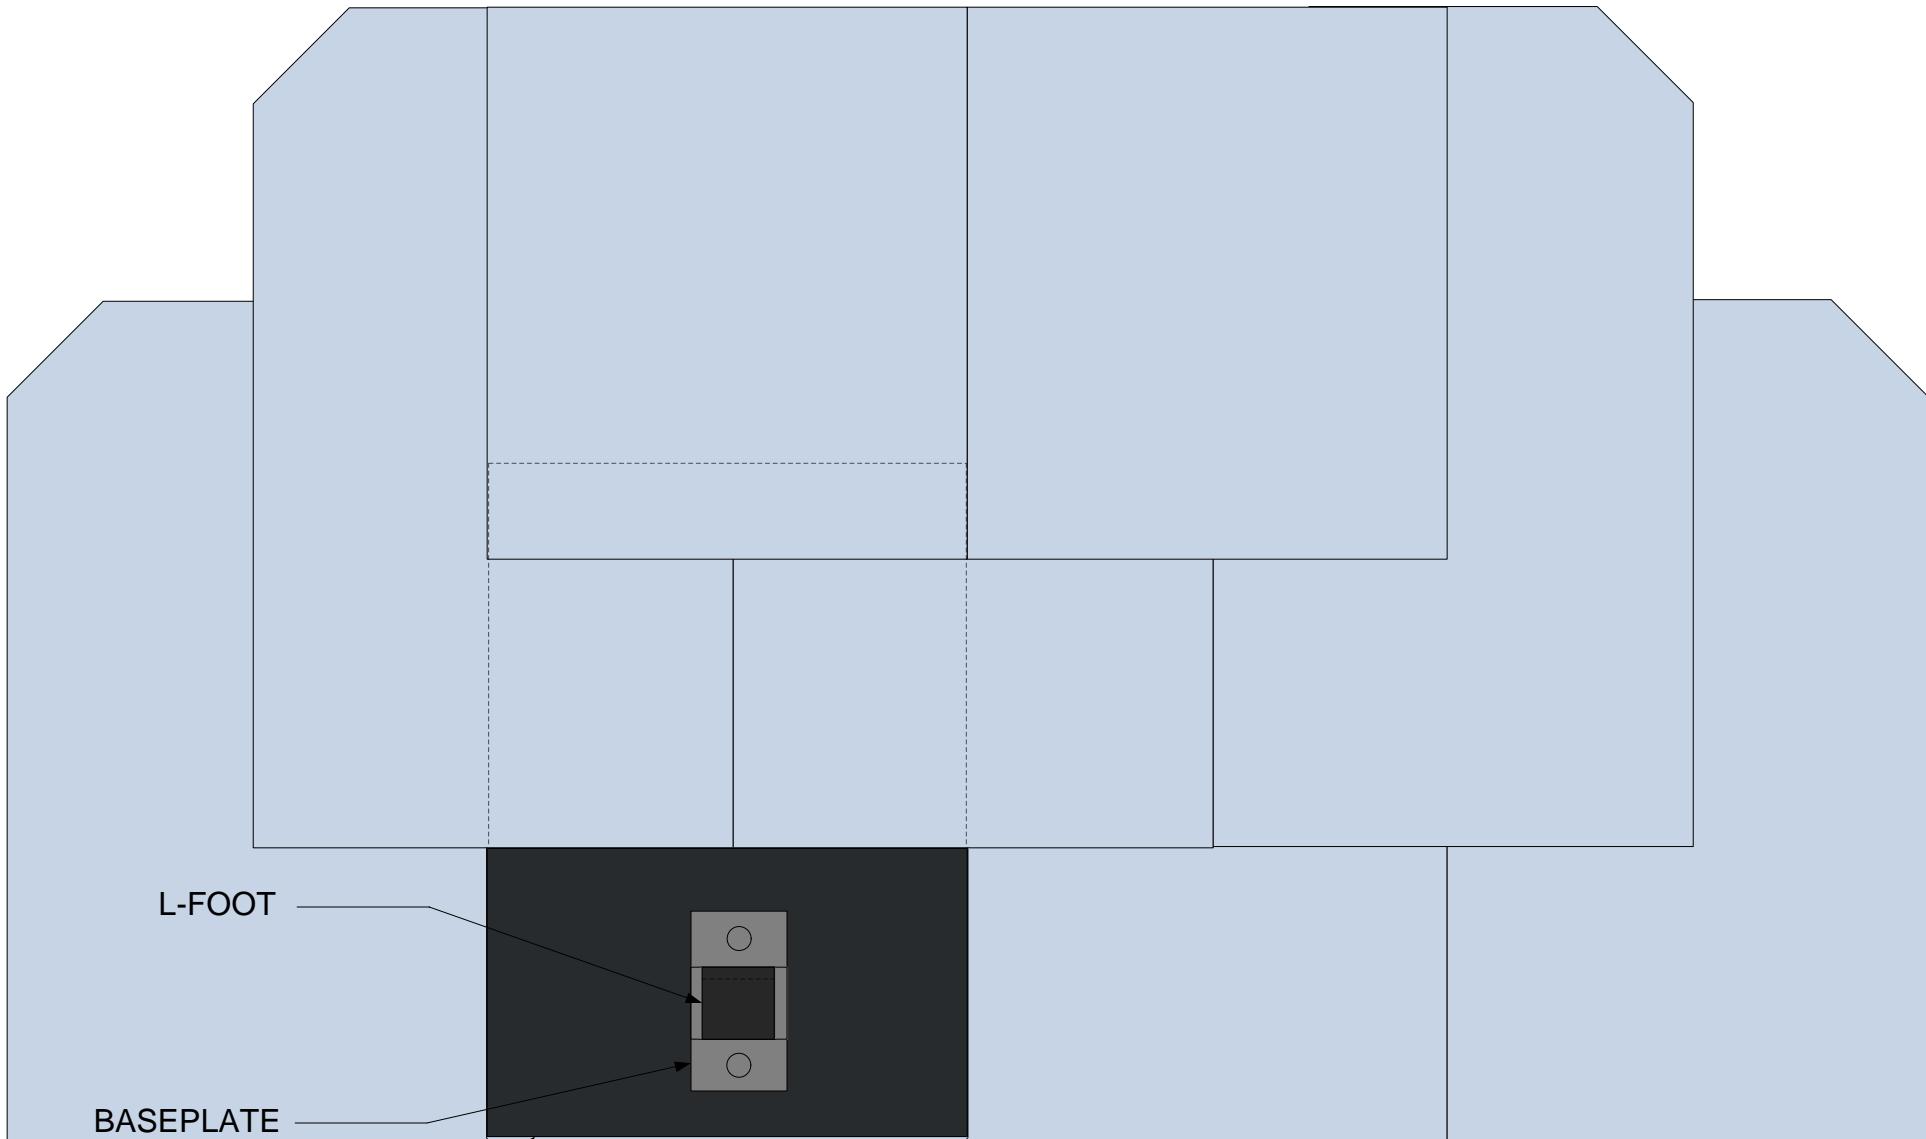

0 3 6  
SCALE IN INCHES  
3" = 1'

|   |   |   |
|---|---|---|
| PROJECT: MICDS  | SHEET TITLE: Flashing Plan View   | ORIG.   |
| SHEET NUMBER: PS-1  |   |   |
| VERSION: Permit & Construction Set  |   |   |
| 09/26/2013  | Scale: 3"=1'<br>Drawn: PK<br>Check:   | 8001 Forsyth Blvd.<br>Floor 2<br>St. Louis, MO 63105<br>Microgrid-Solar.com<br>314.292.5350 |
|  |  |   |