

AS-BUILTS:



Sheet Metal Contractors, Inc.
1661 Veterans Drive
De Soto, MO 63020

Sheet Metal Contractors, Inc.
1661 Veterans Drive

Phone: (636) 337-2150
Fax: (636) 337-6074

GENERAL NOTES:

- A. COORDINATE WITH ALL TRADES PRIOR TO ANY WORK. FCU'S SHALL BE ABLE TO BE REMOVED FROM CEILING. ALLOW MINIMUM 18" CLEAR SPACE AT ACCESS PANELS FOR SERVICING.
 - B. SEE VRV PIPING DIAGRAM SHEET FOR ALL REFRIGERANT PIPE SIZES AND BRANCH SELECTORS.
 - C. SEE AIR DEVICE SCHEDULE FOR ALL FLEX/DUCT SIZES.
 - D. SEE FCU DETAIL ON DETAIL SHEET FOR ALL PIPING, CONTROLS AND DUCT CONNECTIONS.
 - E. SEE PLUMBING SHEETS FOR DRAINS FOR HVAC CONDENSATE DRAINS.
 - F. ALL CONDENSATE PIPING SHALL BE 1" UNLESS OTHERWISE NOTED.
 - G. ALL RETURN AIR TRANSFER DUCTS TO BE 10"x10" IN ROOMS WITH CEILINGS TO WALLS, UNLESS NOTED OTHERWISE.
 - H. CLASSROOM OUTSIDE AIR VALVES SHALL HAVE MINIMUM OF 3-FT. OF LINED FLEX DUCT AT THE DISCHARGE OF THE UNITS.
 - I. ALL VENITLATION AIR DUCTWORK SHALL BE MEDIUM PRESSURE.

KEYED NOTES:

- 1** OUTSIDE AIR VALVE, TITUS MODEL DECV SIZE 6. AIR VALVES CONTROLLED BY CO₂ SENSOR SHALL BE BALANCED FOR 10% MINIMUM. VALVES WITHOUT CO₂ SHALL BE CONSTANT FLOW.
 - 2** CURVED DIFFUSERS WITH CUSTOM BOX 72"L x 6"H x 10"W.
 - 3** 1" DRAIN PIPE DOWN TO FLOOR DRAIN.
 - 4** 1" GAS PIPING TO FIRE PLACE. PROVIDE PRV AND SHUT-OFF VALVE. CONNECT TO FIRE PLACE AS REQUIRED.
 - 18** SMOKE DAMPERS ELIMINATED DUE TO NON COMMUNICATION

Revisions		
No	Name	Date
1	Addendum 1	08-03-2012
6	COORDINATION REV	10-5-2012

Landscape
Architect
SWT DESIGN

7722 Big Bend
St. Louis, MO

Phone: 314.644.5700

Fax: 314.644.6378

Civil
Engineer

11402 Gravois Road, Suite
St. Louis, MO
Phone: 314.729.1400 Fax: 314.729.1404
Mechanical, Electrical, & Plumbing
Engineer
WILLIAM TAO & ASSOCIATES, INC.

7955 Manchester Road, Suite
St. Louis, MO

Phone: Fax:
314.884.7600 314.884.7601

Structural
Engineer
ALPER AUDI, INC.

1804 Borman Circle
St. Louis, MO

Phone: Fax:
314.472.8600 314.472.8630

C E N T E R B R O
O K
Architects and Planners,
IIP
67 Main
Street ox
Centerbrook, Connecticut
06409-0955
telephone
Facsimile 860.767.8719

PHASE: CONSTRUCTION DOCUMENTS

STEM +
C4C =
FIRST FLOOR
B
MECHANICAL

SUED FOR CONSTRUCTION

1100.01 FILE:
CENTERBROOK ARCHITECTS AND PLANNERS


WN BY: DSD	DATE: AUGUST 28, 2012
CKED BY:DLM	SCALE

SCREW B.T.D.EFF SCALE: 1/8" -
1'-0" SHEET:

1

M1.01

—

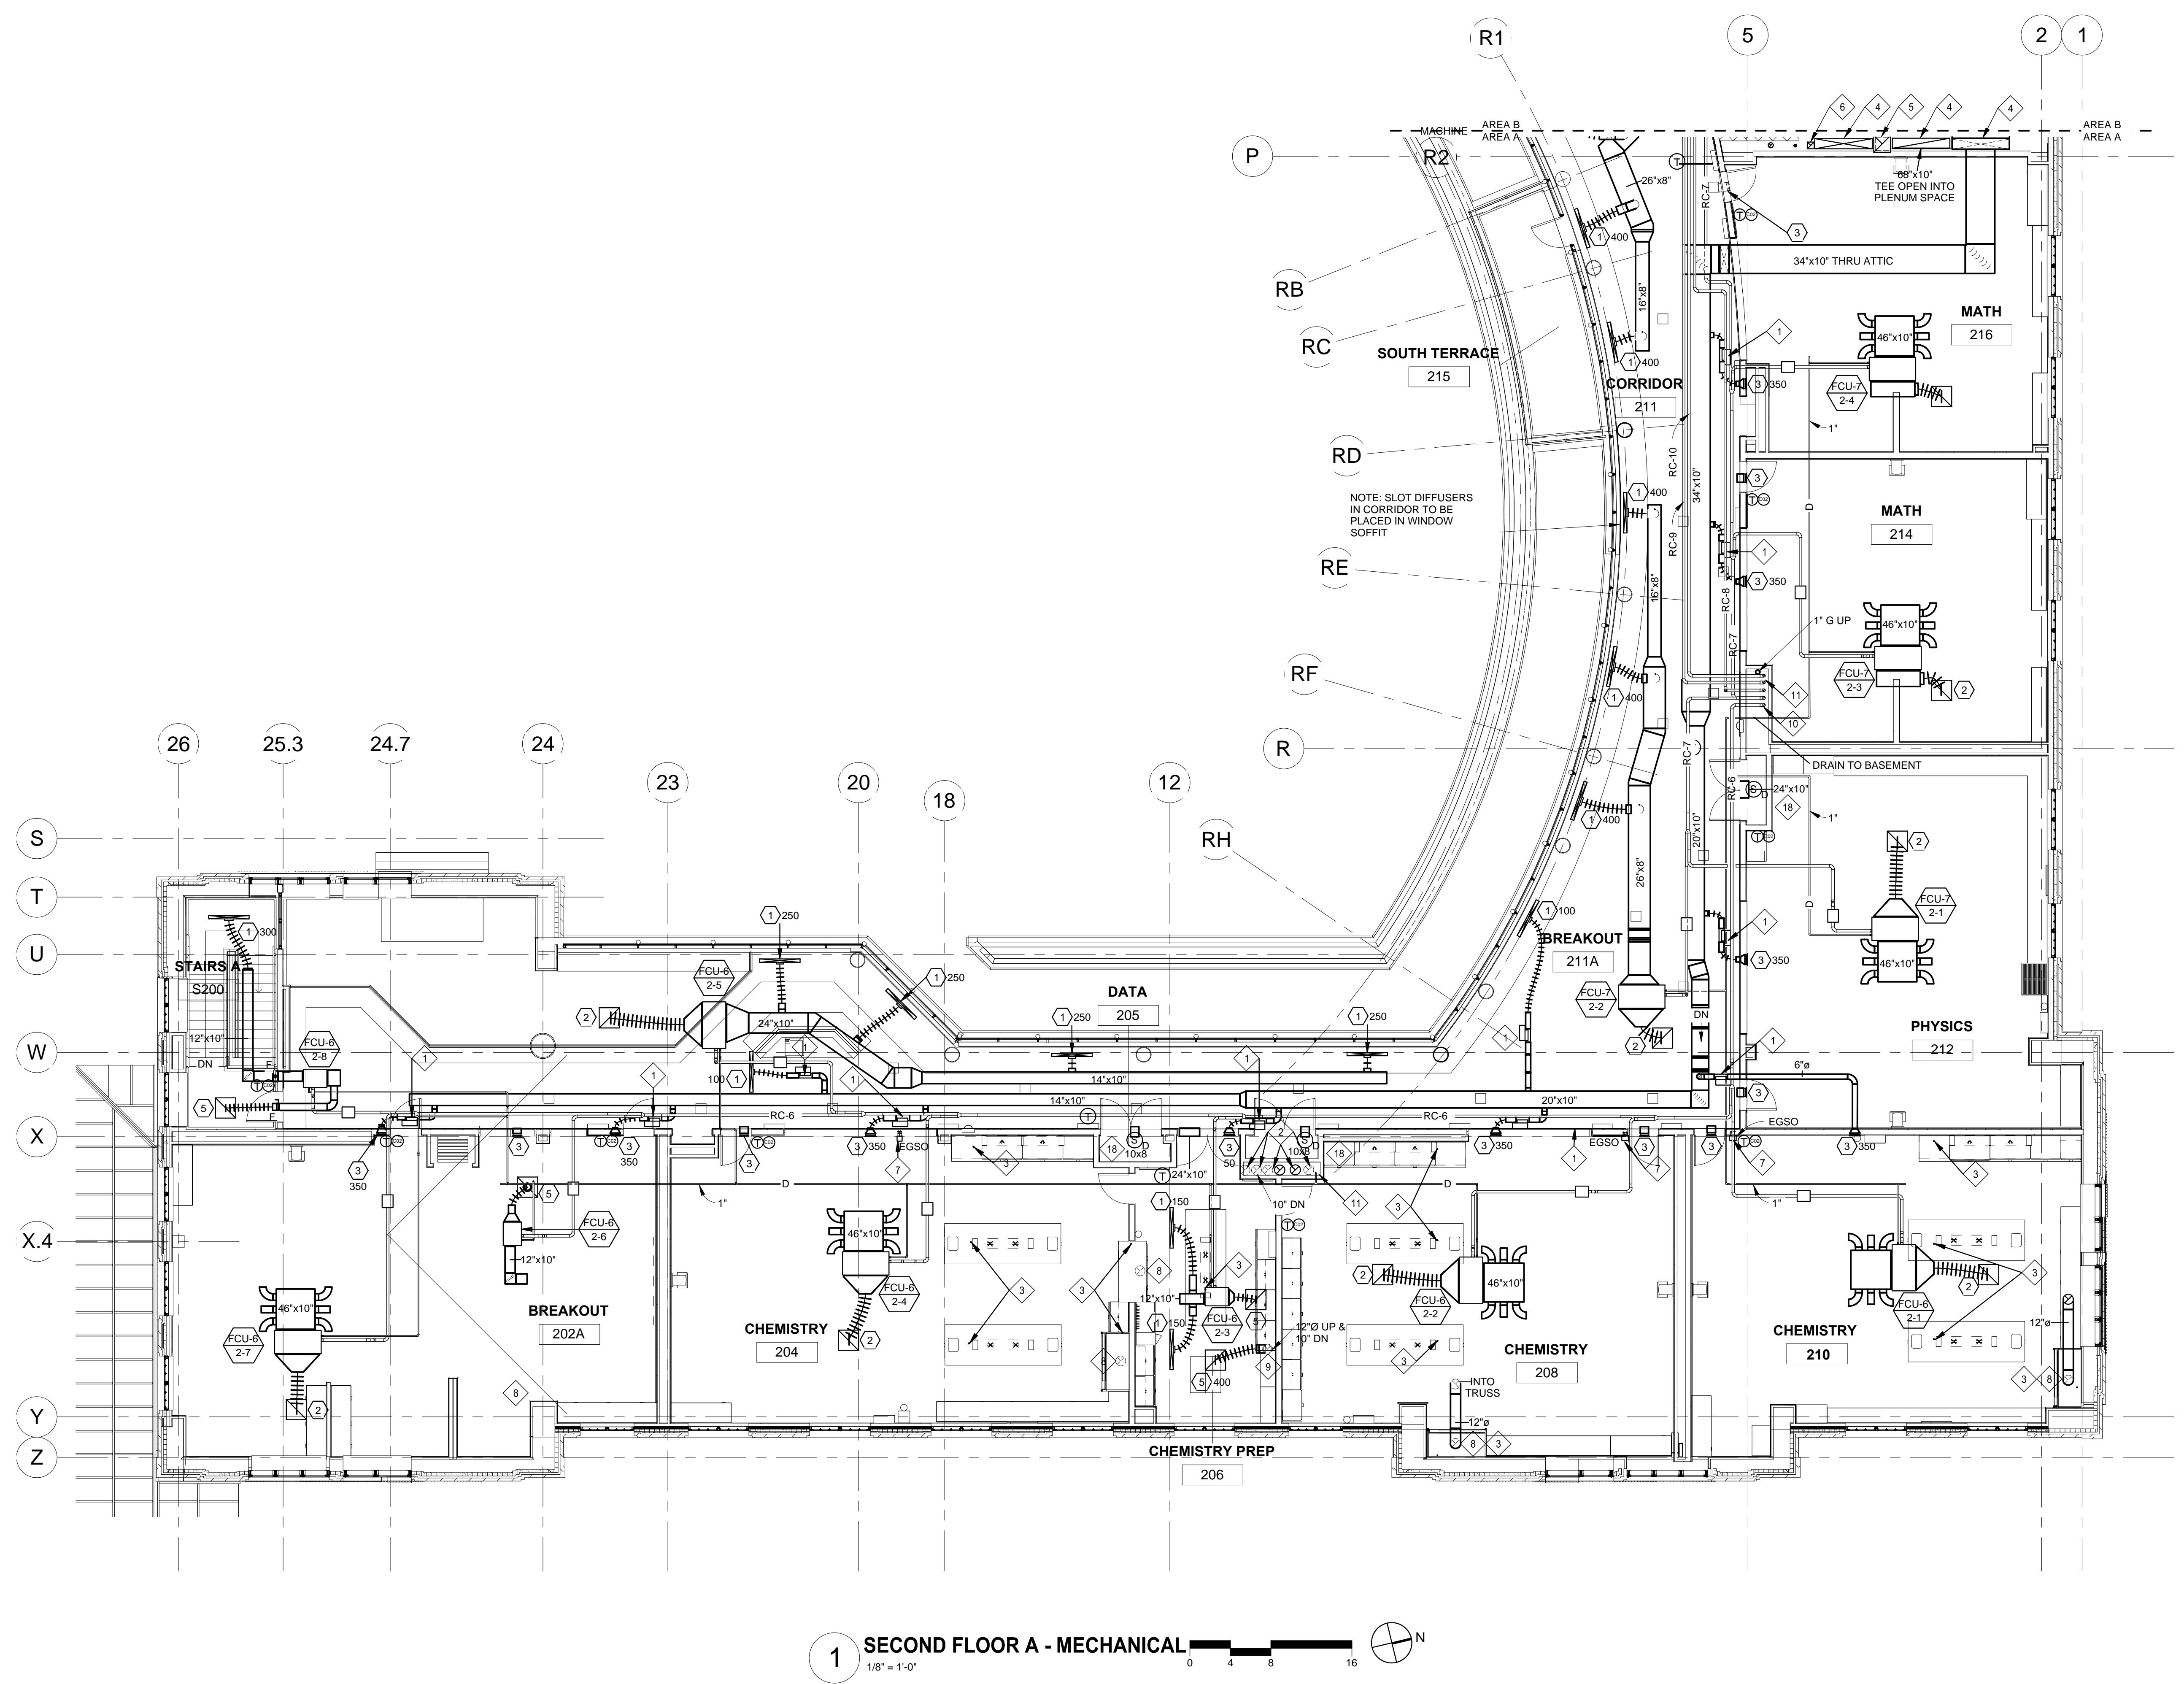

GENERAL NOTES:



Sheet Metal Contractors, Inc.
1661 Veterans Drive
De Soto, MO 63020

Sheet Metal Contractors, Inc.
1661 Veterans Drive
De Soto, MO 63020

Phone: (636) 337-2150
Fax: (636) 337-6074

- A. COORDINATE WITH ALL TRADES PRIOR TO ANY WORK. FCU'S SHALL BE ABLE TO BE REMOVED FROM CEILING. ALLOW MINIMUM 18" CLEAR SPACE AT ACCESS PANELS FOR SERVICING.
 - B. SEE VRV PIPING DIAGRAM SHEET FOR ALL REFRIGERANT PIPE SIZES AND BRANCH SELECTORS.
 - C. SEE AIR DEVICE SCHEDULE FOR ALL FLEX/DUCT SIZES.
 - D. SEE FCU DETAIL ON DETAIL SHEET FOR ALL PIPING, CONTROLS AND DUCT CONNECTIONS.
 - E. SEE PLUMBING SHEETS FOR DRAINS FOR HVAC CONDENSATE DRAINS.
 - F. ALL CONDENSATE PIPING SHALL BE 1" UNLESS OTHERWISE NOTED.
 - G. ALL RETURN AIR TRANSFER DUCTS TO BE 10"x10" IN ROOMS WITH CEILINGS TO WALLS, UNLESS NOTED OTHERWISE.
 - H. CLASSROOM OUTSIDE AIR VALVES SHALL HAVE MINIMUM OF 3-FT. OF LINED FLEX DUCT AT THE DISCHARGE OF THE UNITS.
 - I. ALL VENITLATION AIR DUCTWORK SHALL BE MEDIUM PRESSURE.

KEYED NOTES:

- 1 OUTSIDE AIR VALVE, TITUS MODEL DECV SIZE 6. AIR VALVES CONTROLLED BY CO2 SENSOR SHALL BE BALANCED FOR 10% MINIMUM. VALVES WITHOUT CO2 SHALL BE CONSTANT FLOW.
 - 2 12"Ø FUME HOOD EXHAUST UP TO ATTIC AND DOWN TO FIRST FLOOR. SEE SPEC FOR MATERIAL. CONNECT TO HOOD AS REQUIRED.
 - 3 GAS PIPING AT EACH BENCH, PROVIDE MANUAL AND ELECTRIC SHUT-OFF VALVES AND TWO QUAD NOZZLES. IN EACH HOOD PROVIDE PIPING, MANUAL AND ELECTRIC SAFETY SHUT-OFF AND ONE DUPLEX NOZZLE.
 - 4 68"x12" OUTSIDE AIR, SUPPLY AIR AND RETURN AIR UP & DOWN.
 - 5 18"x18" EXHAUST AIR DOWN AND 20"x20" UP.
 - 6 8"x8" EXHAUST AIR UP AND DOWN.
 - 7 EMERGENCY GAS SHUT-OFF (EGSO) INSTALL VALVE IN A FLUSH MOUNTED LOCK BOX WITH GLASS DOOR. LABEL WITH EMERGENCY GAS SHUT-OFF.
 - 8 12"Ø FUME HOOD EXHAUST, SEE SPEC FOR MATERIAL AND FIREWRAP. CONNECT TO HOOD AS REQUIRED. SEE ATTIC PLAN FOR DUCTWORK CONTINUATION AND EXHAUST FAN LOCATION.
 - 9 12"Ø EXHAUST UP, SEE SPEC FOR MATERIAL AND FIREWRAP. SEE ATTIC PLAN FOR DUCTWORK CONTINUATION AND EXHAUST FAN LOCATION.
 - 10 RC PIPING DOWN TO MECHANICAL ROOM AND CONNECT TO HRS-1 & HRS-2.
 - 11 1" DRAIN PIPE DOWN.
 - 18 SMOKE DAMPER

Revisions		
No	Name	Date
6	COORDINATION REV	10-5-2012

Landscape
Architect
SWT DESIGN

SWI DESIGN
7722 Big Bend
St. Louis, MO
Phone: 314-583-5444

Phone: 314.644.5700 Fax: 314.644.6378
Civil
Engineer
CIVIL ENGINEERING DESIGN CONSULTANTS

11402 Gravois Road, Suite
St. Louis, MO
Phone: _____ Fax: _____

PHONE: 314.729.1400 FAX: 314.729.1404
Mechanical, Electrical, & Plumbing
Engineer
WILLIAM TAO & ASSOCIATES, INC.

7955 Manchester Road, Suite
St. Louis, MO
Phone: _____ Fax: _____

314.884.7600 314.884.7601
Structural
Engineer
ALPER AUDI, INC.

1804 Borman Circle
St. Louis, MO
Phone: _____ Fax: _____

314.432.8600 314.432.8630

L O K
Architects and Planners,
LIP
67 Main
Street ox
Centerbrook, Connecticut
06409-0955
Telephone
Facsimile 860.767.8719

PHASE: CONSTRUCTION DOCUMENTS

For more information about the study, please contact the study team at 1-800-258-4929 or visit www.cancer.gov.

J:\REVIT\REV2012\11100.01\XFER\OUTGOING\12101001-CAD FILES\~MICDS-2776613.jpg

STEM +
C4C

DRA
SECOND FLOOR A
MECHANICAL

MECHANICAL


ISSUED FOR CONSTRUCTION


JOB 1100.01 FILE:
t


CENTERBROOK ARCHITECTS AND PLANNERS
DRAWN BY: DSD DATE: AUGUST 28,
CHECKED BY DLU 2012 SCALE


CHECKED BY:DLH SCALE: 1/8 -
1'-0" SHEET:

   M1 02 A







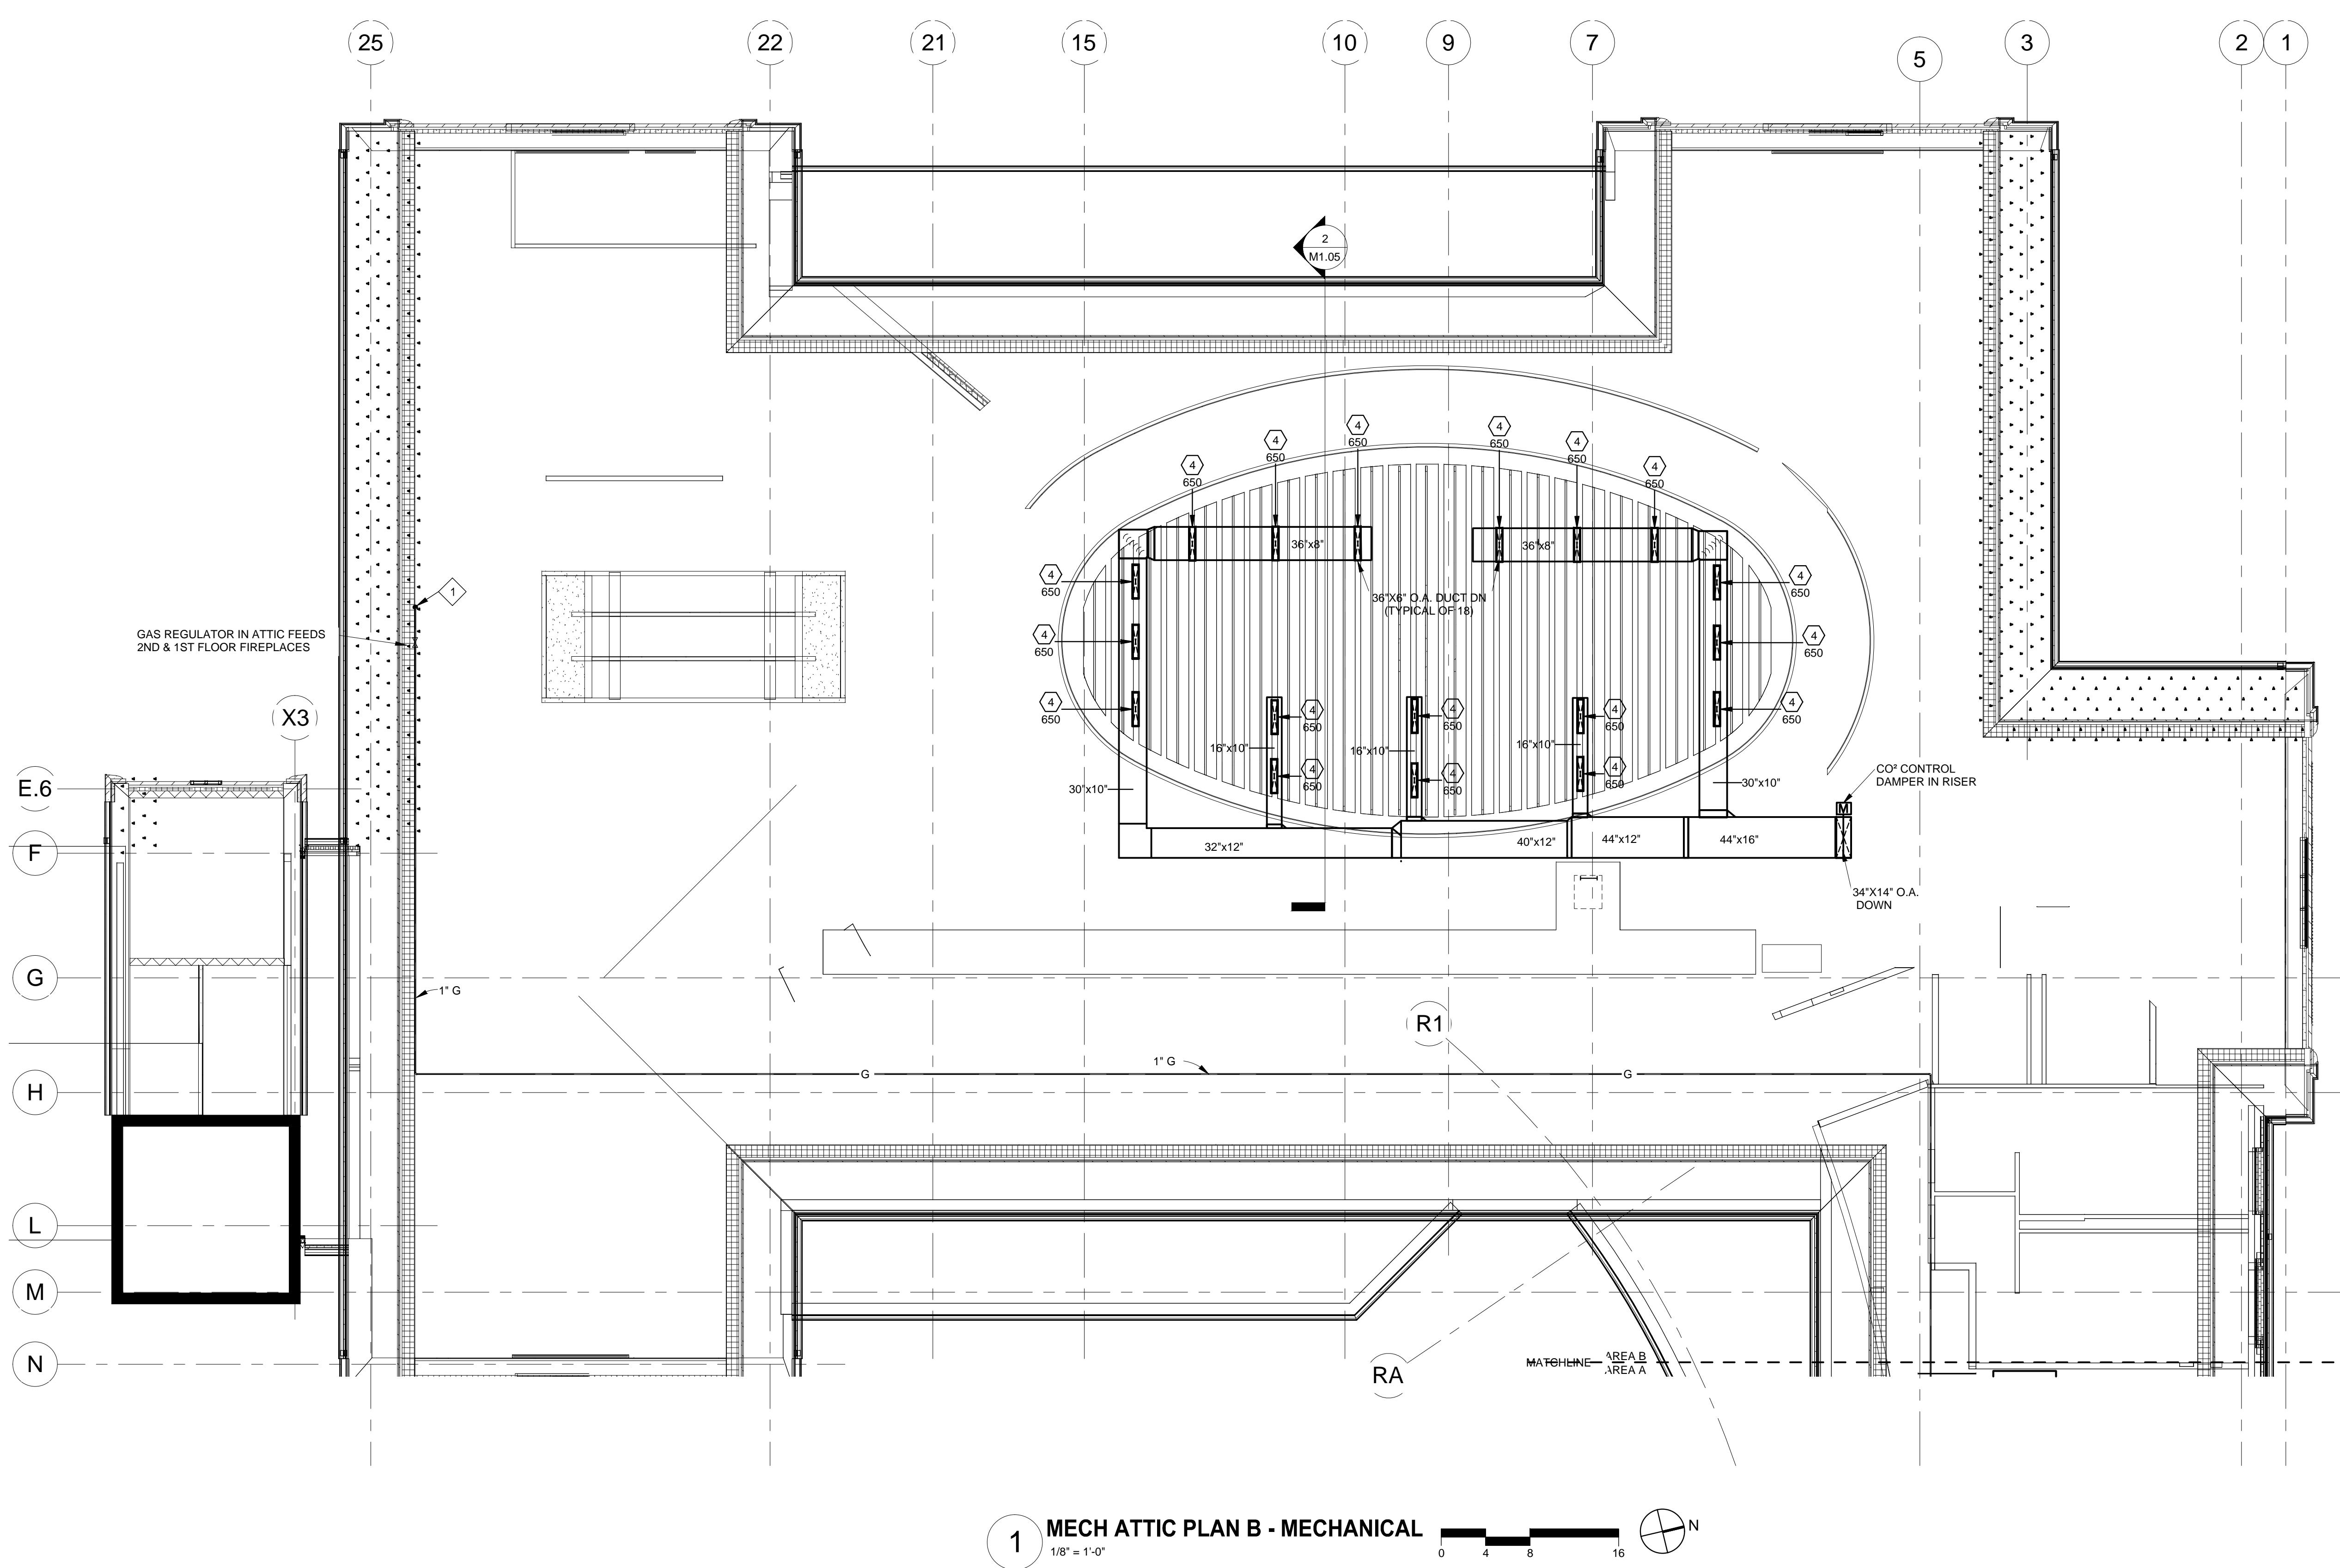

GENERAL NOTES:

- A. COORDINATE WITH ALL TRADES PRIOR TO ANY WORK. FCU'S SHALL BE ABLE TO BE REMOVED FROM CEILING. ALLOW MINIMUM 18" CLEAR SPACE AT ACCESS PANELS FOR SERVICING.
 - B. SEE VRV PIPING DIAGRAM SHEET FOR ALL REFRIGERANT PIPE SIZES AND BRANCH SELECTORS.
 - C. SEE AIR DEVICE SCHEDULE FOR ALL FLEX/DUCT SIZES.
 - D. SEE FCU DETAIL ON DETAIL SHEET FOR ALL PIPING, CONTROLS AND DUCT CONNECTIONS.
 - E. SEE PLUMBING SHEETS FOR DRAINS FOR HVAC CONDENSATE DRAINS.
 - F. ALL CONDENSATE PIPING SHALL BE 1" UNLESS OTHERWISE NOTED.
 - H. ALL VENITLATION AIR DUCTWORK SHALL BE MEDIUM PRESSURE.

KEYED NOTES:

1 1" GAS PIPE DOWN TO FIRE PLACES ON FIRST AND SECOND FLOORS. SEE FIRST AND SECOND FLOOR PLANS.

The diagram illustrates a building's footprint with internal room configurations. The main structure is a large black-shaded area representing the building footprint. Inside this footprint, there are several white areas representing rooms. One room on the left is labeled 'C' above 'B'. Another room on the right is labeled 'B' above 'A'. A third room at the bottom center is also labeled 'B' above 'A'. To the far left, outside the main footprint, is a separate white room labeled 'C' above 'B'. Below the main footprint, there is a fourth room labeled 'A'.

AS-BUILTS:



Sheet Metal Contractors, Inc.
1661 Veterans Drive
De Soto, MO 63020

Phone: (636) 337-2150
Fax: (636) 337-6074

Revisions		
No	Name	Date
6 COORDINATION REV 10-5-2012		
Landscape Architect SWT DESIGN		
7722 Big Bend St. Louis, MO Phone: 314.644.5700	Fax: 314.644.6378	
Civil Engineer CIVIL ENGINEERING DESIGN CONSULTANTS		
11402 Gravois Road, Suite St. Louis, MO Phone: 314.729.1400	Fax: 314.729.1404	
Mechanical, Electrical, & Plumbing Engineer WILLIAM TAO & ASSOCIATES, INC.		
7955 Manchester Road, Suite St. Louis, MO Phone: 314.884.7600	Fax: 314.884.7601	
Structural Engineer ALPER AUDI, INC.		
1804 Borman Circle St. Louis, MO Phone: 314.432.8600	Fax: 314.432.8630	
C E N T E R B R O O K		
Architects and Planners, IIP 67 Main Street ox Centerbrook, Connecticut 06409-0955 Telephone Facsimile 860.767.8719		

E: CONSTRUCTION DOCUMENTS

STEM +
C4C =
ATTIC PLAN B
MECHANICAL

UED FOR CONSTRUCTION

100.01 FILE:

CENTERBROOK ARCHITECTS AND PLANNERS

BY: DSD
ED BY:DLH

100

M1.03E